

TYPEWRITER OR BALL  
POINT PEN-PRESS FIRMLY,  
PRINT CLEARLY.

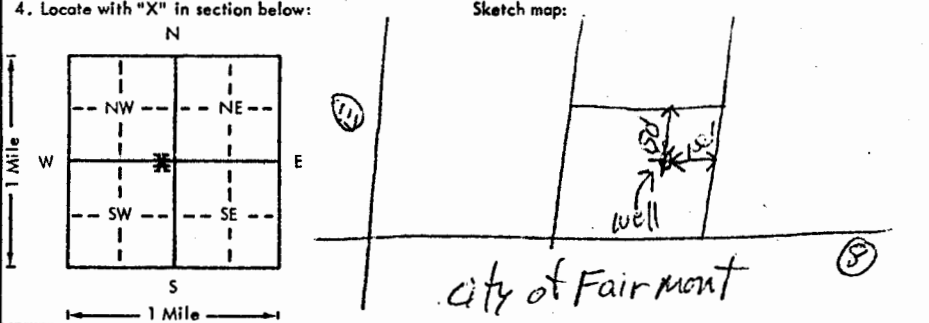
WATER WELL RECORD  
KSA 82a-1201-1215

Kansas Department of Health and  
Environment-Division of Environment  
(Water well Contractors)  
Topeka, Kansas 66620

CAA

105

R

1. Location of well: County <b>Leavenworth</b>		Fraction <b>NE 1/4 NE 1/4 SW 1/4</b>		Section number <b>11</b>		Township number <b>T 10 S R 22E</b>		Range number <b>E/XC</b>	
2. Distance and direction from nearest town or city: <b>In town of Fairmount, Ks.</b> Street address of well location if in city: <b>Rt. 3 Bx. 231 Leavenworth, Ks. 66048</b>					3. Owner of well <b>Ms. L.E. Tiffy</b> R.R. or street: <b>Rt. 3 Bx 231</b> City, state, zip code: <b>Leavenworth, Ks. 66048</b>				
4. Locate with "X" in section below: Sketch map: 					6. Bore hole dia. <b>7 3/8</b> in. Completion date <b>9/77</b> Well depth <b>140'</b> ft.				
5. Type and color of material					7. <input checked="" type="checkbox"/> Cable tool <input checked="" type="checkbox"/> Rotary <input type="checkbox"/> Driven <input type="checkbox"/> Dug <input type="checkbox"/> Hollow rod <input type="checkbox"/> Jetted <input type="checkbox"/> Bored <input type="checkbox"/> Reverse rotary				
8. Use: <input checked="" type="checkbox"/> Domestic <input type="checkbox"/> Public supply <input type="checkbox"/> Industry <input type="checkbox"/> Irrigation <input type="checkbox"/> Air conditioning <input type="checkbox"/> Stock <input type="checkbox"/> Lawn <input type="checkbox"/> Oil field water <input type="checkbox"/> Other					9. Casing: Material <b>steel</b> Height: Above or below Threaded <input type="checkbox"/> Welded <input checked="" type="checkbox"/> Surface <b>12</b> in. RMP <input type="checkbox"/> PVC <input checked="" type="checkbox"/> Weight <b>50</b> lbs./ft. Dia. <b>6 1/4</b> in. to <b>22 1/2</b> depth Wall Thickness: inches or Dia. <b>1 1/2</b> in. to <b>22 1/2</b> depth gage No. <b>1/4 #200</b>				
surface					10. Screens, Manufacturer's name <b>Johnson</b>				
clay (yellow, med. sand traces)					Type <b>Plastic</b> Dia. <b>4 1/2"</b>				
clay (red, med. sand traces)					Slot/gauze <b>0.020"</b> Length <b>5'</b>				
clay (mixed with sandstone)					Set between <b>130</b> ft. and <b>135</b> ft.				
sandstone (brown, clayey, soft)					Gravel pack? <b>yes</b> Size range of material <b>1/4 x 1/8</b>				
shale (grey, sandy)					11. Static water level: <b>30</b> ft. below land surface Date <b>9/3/77</b>				
sandstone (grey, ecc. shale streaks)					12. Pumping level below land surfaces: ____ ft. after ____ hrs. pumping ____ g.p.m. ____ ft. after ____ hrs. pumping ____ g.p.m. Estimated maximum yield <b>4-5</b> g.p.m.				
					13. Water sample submitted: mo./day/yr. Yes <input checked="" type="checkbox"/> No <input type="checkbox"/> Date _____				
					14. Well head completion: <input checked="" type="checkbox"/> Pitless adapter <b>13</b> Inches above grade				
					15. Well grouted? <b>yes</b> With: <input checked="" type="checkbox"/> Neat cement <input type="checkbox"/> Bentonite <input type="checkbox"/> Concrete Depth: From <b>5</b> ft. to <b>35</b> ft.				
					16. Nearest source of possible contamination: ft. <b>300</b> Direction <b>South</b> Type <b>SEPTIC</b> Well disinfected upon completion? <input checked="" type="checkbox"/> Yes <input type="checkbox"/> No				
					17. Pump: <input checked="" type="checkbox"/> Not installed Manufacturer's name _____ Model number _____ HP _____ Volts _____ Length of drop pipe _____ ft. capacity _____ g.p.m. Type: <input type="checkbox"/> Submersible <input type="checkbox"/> Turbine <input type="checkbox"/> Jet <input type="checkbox"/> Reciprocating <input type="checkbox"/> Centrifugal <input type="checkbox"/> Other				
note: 82' 6 1/4 steel @ 13 lbs per foot 70' 4 1/2 PVC @ 1.75 lbs. per foot (Use a second sheet if needed)					20. Water well contractor's certification: This well was drilled under my jurisdiction and this report is true to the best of my knowledge and belief. <b>Young Drilling</b> <b>240</b> Business name License No. Address <b>6355 Robinhood Meridian Ks</b> Signed <b>David Young</b> Date <b>10-22</b> Authorized representative				
18. Elevation: <b>940'</b>		19. Remarks: Customer is aware of state regulation and agrees to install a 4' square re-enforced concrete platform around top of well.							
Topography: <input type="checkbox"/> Hill <input checked="" type="checkbox"/> Upland <input type="checkbox"/> Valley		<b>L.E. Tiffy</b>							

Forward the white, blue and pink copies to the Department of Health and Environment

Form WWC-5

BR elev = 865      9 = 910

✓  
CK