


1 LOCATION OF WATER WELL: Fraction NE 1/4 NW 1/4 NW 1/4 Section Number 16 Township Number T 10 S Range Number R 22 E
 County Leavenworth

Distance and direction from nearest town or city street address of well if located within city?
3 1/2 Miles NW of Basehor

2 WATER WELL OWNER: William J. Lee
 RR#, St. Address, Box #: RRI
 City, State, ZIP Code: Basehor, Kansas 66007
 Board of Agriculture, Division of Water Resources
 Application Number: _____

3 LOCATE WELL'S LOCATION WITH AN "X" IN SECTION BOX:

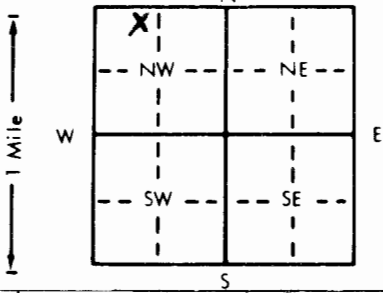

4 DEPTH OF COMPLETED WELL: 120 ft. ELEVATION: 950'
 Depth(s) Groundwater Encountered 1. 43 ft. 2. _____ ft. 3. _____ ft.
 WELL'S STATIC WATER LEVEL: 31 ft. below land surface measured on mo/day/yr 5-22-86
 Pump test data: Well water was _____ ft. after _____ hours pumping _____ gpm
 Est. Yield 1/3 gpm: Well water was _____ ft. after _____ hours pumping _____ gpm
 Bore Hole Diameter: 8 in. to 120 ft., and _____ in. to _____ ft.
 WELL WATER TO BE USED AS:
 1 Domestic 3 Feedlot 6 Oil field water supply 9 Dewatering 12 Other (Specify below)
 2 Irrigation 4 Industrial 7 Lawn and garden only 10 Observation well
 Was a chemical/bacteriological sample submitted to Department? Yes _____ No If yes, mo/day/yr sample was submitted _____
 Water Well Disinfected? Yes No _____

5 TYPE OF BLANK CASING USED:
 1 Steel 3 RMP (SR) 6 Asbestos-Cement 9 Other (specify below) _____
 2 PVC 4 ABS 7 Fiberglass 8 Concrete tile 10 Asbestos-cement
 Blank casing diameter: 5 in. to 43 ft., Dia 5 in. to 120 ft., Dia _____ in. to _____ ft.
 Casing height above land surface: 18 in., weight _____ lbs./ft. Wall thickness or gauge No. _____

TYPE OF SCREEN OR PERFORATION MATERIAL:
 1 Steel 3 Stainless steel 5 Fiberglass 7 PVC 10 Asbestos-cement
 2 Brass 4 Galvanized steel 6 Concrete tile 8 RMP (SR) 11 Other (specify) _____
 12 None used (open hole)

SCREEN OR PERFORATION OPENINGS ARE:
 1 Continuous slot 3 Mill slot 5 Gauzed wrapped 8 Saw cut 11 None (open hole)
 2 Louvered shutter 4 Key punched 6 Wire wrapped .010" 9 Drilled holes 10 Other (specify) _____
 7 Torch cut 10 Other (specify) _____

SCREEN-PERFORATED INTERVALS: From 43 ft. to 47 ft., From _____ ft. to _____ ft.
 From _____ ft. to _____ ft., From _____ ft. to _____ ft.
 GRAVEL PACK INTERVALS: From 25 ft. to 120 ft., From _____ ft. to _____ ft.
 From _____ ft. to _____ ft., From _____ ft. to _____ ft.

6 GROUT MATERIAL: 1 Neat cement 2 Cement grout 3 Bentonite 4 Other _____
 Grout Intervals: From 13 ft. to 25 ft., From _____ ft. to _____ ft., From _____ ft. to _____ ft.

What is the nearest source of possible contamination:
 1 Septic tank 4 Lateral lines 7 Pit privy 10 Livestock pens 14 Abandoned water well
 2 Sewer lines 5 Cess pool 8 Sewage lagoon 11 Fuel storage 15 Oil well/Gas well
 3 Watertight sewer lines 6 Seepage pit 9 Feedyard 12 Fertilizer storage 16 Other (specify below) _____
 13 Insecticide storage _____
 Direction from well? SOUTH How many feet? 150

FROM	TO	LITHOLOGIC LOG	FROM	TO	LITHOLOGIC LOG
0	1	Surface			
1	16	Clay			
16	18	Clay sandy			
18	30	Sand & Fine gravel			
30	45	Sand & Medium gravel			
45	51	Sandstone Red clayey			
51	57	Shale grey			
57	67	Sandstone layers in shale			
67	92	Shale			
92	93	Sandstone			
93	120	Shale sandy			

7 CONTRACTOR'S OR LANDOWNER'S CERTIFICATION: This water well was (1) constructed, (2) reconstructed, or (3) plugged under my jurisdiction and was completed on (mo/day/year) 5-22-86 and this record is true to the best of my knowledge and belief. Kansas Water Well Contractor's License No. 240 This Water Well Record was completed on (mo/day/yr) 6-10-86 under the business name of F.E. Young Drilling Co. by (signature) David Young

INSTRUCTIONS: Use typewriter or ball point pen, PLEASE PRESS FIRMLY and PRINT clearly. Please fill in blanks, underline three copies to Kansas Department of Health and Environment, Division of Environment, Environmental Geology Section, Topeka, Kansas and retain one for your records.