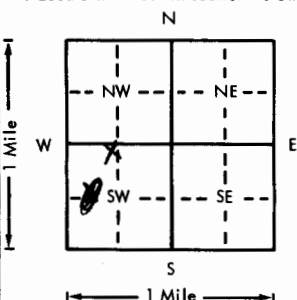


USE TYPEWRITER OR BALL POINT PEN-PRESS FIRMLY, PRINT CLEARLY.

WATER WELL RECORD
KSA 82a-1201-1215

Kansas Department of Health and Environment-Division of Environment (Water well Contractors)
Topeka, Kansas 66620

CBA

1. Location of well:		County Leavenworth	Fraction ENE 1/4 NW 1/4 SW 1/4	Section number 17	Township number T 10 S R 22	Range number 22																					
2. Distance and direction from nearest town or city: Street address of well location if in city: 3 miles west & 3/4 mile south of Fairmount			3. Owner of well: Mr. John Neas R.R. or street: Route 2 Box 57 City, state, zip code: Tonganoxie, Kansas																								
4. Locate with "X" in section below: Sketch map: 			6. Bore hole dia 100 in. Completion date 6-17-76 Well depth 100 ft.																								
5. Type and color of material			7. <input checked="" type="checkbox"/> Cable tool <input checked="" type="checkbox"/> Rotary <input type="checkbox"/> Driven <input type="checkbox"/> Dug <input type="checkbox"/> Hollow rod <input type="checkbox"/> Jetted <input type="checkbox"/> Bored <input type="checkbox"/> Reverse rotary																								
			8. Use: <input checked="" type="checkbox"/> Domestic <input type="checkbox"/> Public supply <input type="checkbox"/> Industry <input type="checkbox"/> Irrigation <input type="checkbox"/> Air conditioning <input type="checkbox"/> Stock <input type="checkbox"/> Lawn <input type="checkbox"/> Oil field water <input type="checkbox"/> Other																								
<table border="1"> <thead> <tr> <th></th> <th>From</th> <th>To</th> </tr> </thead> <tbody> <tr> <td>Top Soil</td> <td>0</td> <td>3</td> </tr> <tr> <td>Clay</td> <td>3</td> <td>10</td> </tr> <tr> <td>Soft Sandy Clay</td> <td>10</td> <td>30</td> </tr> <tr> <td>Blue Mud</td> <td>30</td> <td>58</td> </tr> <tr> <td>Sand</td> <td>58</td> <td>64</td> </tr> <tr> <td>Sandy Shale</td> <td>64</td> <td>100</td> </tr> </tbody> </table>				From	To	Top Soil	0	3	Clay	3	10	Soft Sandy Clay	10	30	Blue Mud	30	58	Sand	58	64	Sandy Shale	64	100	9. Casing: Material PL Height: Above or below Threaded <input type="checkbox"/> Welded <input checked="" type="checkbox"/> Surface <input type="checkbox"/> in. RMP <input type="checkbox"/> PVC <input checked="" type="checkbox"/> Weight <input type="checkbox"/> lbs./ft. Dia. 0 in. to 102 ft. depth Wall Thickness: inches or Dia. <input type="checkbox"/> in. to <input type="checkbox"/> ft. depth gage No. 258			
				From	To																						
Top Soil	0	3																									
Clay	3	10																									
Soft Sandy Clay	10	30																									
Blue Mud	30	58																									
Sand	58	64																									
Sandy Shale	64	100																									
			10. Screen: Manufacturer's name Vinylplex, Inc. Type PVC Dia. <input type="checkbox"/> Slot/gauze 06 1/16 Length <input type="checkbox"/> Set between 58 ft. and 64 ft. <input type="checkbox"/> ft. and <input type="checkbox"/> ft. Gravel pack? <input checked="" type="checkbox"/> Size range of material 1/8 - 1/4																								
			11. Static water level: 40 1/2 ft. below land surface Date 6-17-76 mo./day/yr.																								
			12. Pumping level below land surfaces: <input type="checkbox"/> ft. after <input type="checkbox"/> hrs. pumping <input type="checkbox"/> g.p.m. <input type="checkbox"/> ft. after <input type="checkbox"/> hrs. pumping <input type="checkbox"/> g.p.m. Estimated maximum yield 20 g.p.m.																								
			13. Water sample submitted: <input type="checkbox"/> Yes <input checked="" type="checkbox"/> No Date <input type="checkbox"/>																								
			14. Well head completion: <input checked="" type="checkbox"/> Pitless adapter 18 inches above grade																								
			15. Well grouted? Yes With: <input checked="" type="checkbox"/> Neat cement <input type="checkbox"/> Bentonite <input type="checkbox"/> Concrete Depth: From 3 ft. to 23 ft.																								
			16. Nearest source of possible contamination: 100 ft. Direction West Type Lagoon Well disinfected upon completion? <input checked="" type="checkbox"/> Yes <input type="checkbox"/> No																								
			17. Pump: <input type="checkbox"/> Not installed Manufacturer's name Jacuzzi Model number 7SLC HP 3/4 Volts 220 Length of drop pipe 90 ft. capacity 15 g.p.m. Type: <input checked="" type="checkbox"/> Submersible <input type="checkbox"/> Turbine <input type="checkbox"/> Jet <input type="checkbox"/> Reciprocating <input type="checkbox"/> Centrifugal <input type="checkbox"/> Other																								
18. Elevation: 915			20. Water well contractor's certification: This well was drilled under my jurisdiction and this report is true to the best of my knowledge and belief. BREUER, INC. 174 Business name Box 147 Basehor License No. KS 66007 Address Basehor, KS Signed [Signature] Date 6/18/76																								
19. Remarks: 850 gpm @ 20 ft																											

Forward the white, blue and pink copies to the Department of Health and Environment

Form WWC-5

BR elev = 851
821

10 220 17
 T
 R
 Sec
 1/4 SW NW SW