


USE TYPEWRITER OR BALL POINT PEN-PRESS FIRMLY, PRINT CLEARLY.

WATER WELL RECORD
KSA 82a-1201-1215

Kansas Department of Health and Environment
Division of Environment (Water well Contractors)
Topeka, Kansas 66620

1. Location of well: County **Leavenworth** Fraction **NW 1/4 NW 1/4 NE 1/4** Section number **19** Township number **T 10 S R 22** Range number **EW**

2. Distance and direction from nearest town or city: **3 miles north & 3 miles west of Basehor, Kansas**
 3. Owner of well: **Mr. Jim Esaw**
 R.R. or street: **2215 N. 20th**
 City, state, zip code: **Kansas City, Kansas**

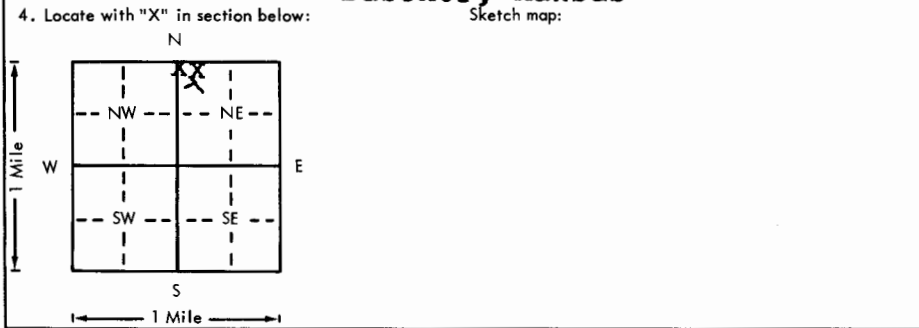

6. Bore hole dia. **8** in. Completion date **7-19-78**
 Well depth **75** ft.
 7. Cable tool Rotary Driven Dug
 Hollow rod Jetted Bored Reverse rotary
 8. Use: Domestic Public supply Industry
 Irrigation Air conditioning Stock
 Lawn Oil field water Other
 9. Casing: Material **PL.** Height: Above or below
 Threaded Welded Surface **18** in.
 RMP PVC Weight _____ lbs./ft.
 Dia. **5** in. to **76** ft. depth Wall Thickness: inches or
 Dia. _____ in. to _____ ft. depth Gauge No. **265**

5. Type and color of material	From	To
Top Soil	0	2
Clay	2	15
Sandy Clay	15	35
Silt - Sandy	35	55
Gravel	55	57
Lime	57	75

10. Screen: Manufacturer's name **(Slotted Pipe) Vinylplex, Inc.**
 Type **PVC** Dia. **5"**
 Slot/gauze **.06 1/16** Dia. Length **45'**
 Set between **30** ft. and **75** ft.
 _____ ft. and _____ ft.
 Gravel pack? Size range of material **1/4 - 1/8**
 11. Static water level: _____ mo./day/yr.
31 ft. below land surface Date **7-19-78**
 12. Pumping level below land surfaces:
 _____ ft. after _____ hrs. pumping _____ g.p.m.
 _____ ft. after _____ hrs. pumping _____ g.p.m.
 Estimated maximum yield **15** g.p.m.
 13. Water sample submitted: _____ mo./day/yr.
 Yes No Date _____
 14. Well head completion: Pitless adapter **18** Inches above grade
 15. Well grouted? **Yes**
 With: Neat cement Bentonite Concrete
 Depth: From **3** ft. to **15** ft.
 16. Nearest source of possible contamination:
 ft. **200'** Direction **east** Type **septic**
 Well disinfected upon completion? Yes No
 17. Pump: _____ Not installed
 Manufacturer's name **Jacuzzi**
 Model number **5S4B** HP **1/2** Volts **220**
 Length of drop pipe **65** ft. capacity **10** g.p.m.
 Type: Submersible Turbine
 Jet Reciprocating
 Centrifugal Other

18. Elevation:
 Topography:
 Hill
 Slope
 Upland
 Valley

19. Remarks:
 (Use a second sheet if needed)

20. Water well contractor's certification:
 This well was drilled under my jurisdiction and this report is true to the best of my knowledge and belief.
BREUER, INC. **174**
 Business name License No.
 Address **Box 147, Basehor, Ks.**
 Signed **People's Well** Date **July 21, 1978**
 Authorized representative

T
 R
 W
 Sec
 19
 1/4
 1/4
 1/4
 1/4
 NW
 NE
 SE
 SW