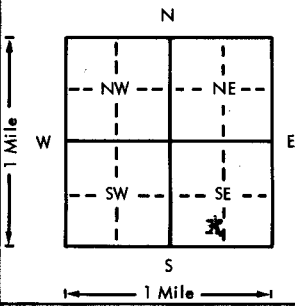


USE TYPEWRITER OR BALL POINT PEN-PRESS FIRMLY, PRINT CLEARLY.

WATER WELL RECORD
KSA 82a-1201-1215

Kansas Department of Health and Environment
Division of Environment
(Water well Contractors)
Topeka, Kansas 66620

Location of well:	County Leavenworth	Fraction SE 1/4 SW 1/4 SE 1/4	Section number 19	Township number 10 S R	Range number 22 EW
Distance and direction from nearest town or city: 1 mile north, 4 miles west of Basehor, Ks.			3. Owner of well: Mr. Ed Standish R.R. or street: 1205 North 90th Street City, state, zip code: Kansas City, Kansas		
4. Locate with "X" in section below: 			6. Bore hole dia. 8 in. Completion date 5-4-76 Well depth 100 ft.		
5. Type and color of material			7. <input type="checkbox"/> Cable tool <input checked="" type="checkbox"/> Rotary <input type="checkbox"/> Driven <input type="checkbox"/> Dug <input type="checkbox"/> Hollow rod <input type="checkbox"/> Jetted <input type="checkbox"/> Bored <input type="checkbox"/> Reverse rotary		
Sandy Top Soil			8. Use: <input checked="" type="checkbox"/> Domestic <input type="checkbox"/> Public supply <input type="checkbox"/> Industry <input type="checkbox"/> Irrigation <input type="checkbox"/> Air conditioning <input type="checkbox"/> Stock <input type="checkbox"/> Lawn <input type="checkbox"/> Oil field water <input type="checkbox"/> Other		
Sandy Clay - Yellow			9. Casing: Material PL Height: Above or below Threaded <input type="checkbox"/> Welded <input checked="" type="checkbox"/> Surface 18 in. RMP <input type="checkbox"/> PVC <input checked="" type="checkbox"/> Weight <input type="checkbox"/> lbs./ft. Dia. 5 in. to 100 ft. depth Wall Thickness: inches or Dia. <input type="checkbox"/> in. to <input type="checkbox"/> ft. depth gage No. 258		
Sandstone - Yellow			10. Screen: Manufacturer's name Vinylplex, Inc. Type PVC Dia. 5 3/8 Slot/gauze 06 1/16 Length 30 Set between 50 ft. and 80 ft. Cemented in ft. and 0 to 40 ft. ft. Gravel pack? <input checked="" type="checkbox"/> Size range of material <input checked="" type="checkbox"/>		
Sandstone - Gray			11. Static water level: 30 ft. below land surface Date 5-4-76		
Lime - White			12. Pumping level below land surfaces: <input type="checkbox"/> ft. after <input type="checkbox"/> hrs. pumping <input type="checkbox"/> g.p.m. <input type="checkbox"/> ft. after <input type="checkbox"/> hrs. pumping <input type="checkbox"/> g.p.m. Estimated maximum yield 7 g.p.m.		
Shale - Blue			13. Water sample submitted: <input type="checkbox"/> Yes <input checked="" type="checkbox"/> No Date <input type="checkbox"/>		
Slate - Black			14. Well head completion: <input checked="" type="checkbox"/> Pitless adapter 18 Inches above grade		
Lime - White			15. Well grouted? <input checked="" type="checkbox"/> Yes With: <input checked="" type="checkbox"/> Neat cement <input type="checkbox"/> Bentonite <input type="checkbox"/> Concrete Depth: From 3 ft. to 40 ft.		
Shale - Blue			16. Nearest source of possible contamination: ft. 100 Direction SE Type Septic Well disinfected upon completion? <input checked="" type="checkbox"/> Yes <input type="checkbox"/> No		
(Use a second sheet if needed)			17. Pump: <input type="checkbox"/> Not installed Manufacturer's name Jacuzzi Model number 554B HP 1/2 Volts 220 Length of drop pipe <input type="checkbox"/> ft. capacity <input type="checkbox"/> g.p.m. Type: <input checked="" type="checkbox"/> Submersible <input type="checkbox"/> Turbine <input type="checkbox"/> Jet <input type="checkbox"/> Reciprocating <input type="checkbox"/> Centrifugal <input type="checkbox"/> Other		
18. Elevation:	19. Remarks:		20. Water well contractor's certification: This well was drilled under my jurisdiction and this report is true to the best of my knowledge and belief. BREUER, INC. 174 Business name License No. Address Box 147 Basehor, Ks. 66007 Signed <i>[Signature]</i> Date 5/6		
Topography: <input type="checkbox"/> Hill <input type="checkbox"/> Slope <input type="checkbox"/> Upland <input type="checkbox"/> Valley					

Forward the white, blue and pink copies to the Department of Health and Environment

Form WWC-5

T 10
R 22
W 19
S 17
E 17
