

222

not
DEW

7/27/78

USE TYPEWRITER OR BALL
POINT PEN-PRESS FIRMLY,
PRINT CLEARLY.


WATER WELL RECORD
KSA 82a-1201-1215

Kansas Department of Health and
Environment-Division of Environment
(Water well Contractors)
Topeka, Kansas 66620

~~DDC DCA C~~

1. Location of well:	County Leavenworth	Fraction NE 1/4 SW 1/4 SE 1/4	Section number 21	Township number T 10 S R 22 (E/W)	Range number
----------------------	------------------------------	---	-----------------------------	---	--------------

2. Distance and direction from nearest town or city: **1 mile north & 1 mile west of Basehor, Kansas**
 3. Owner of well: **John Miller (Builder)**
 R.R. or street:
 City, state, zip code: **??**

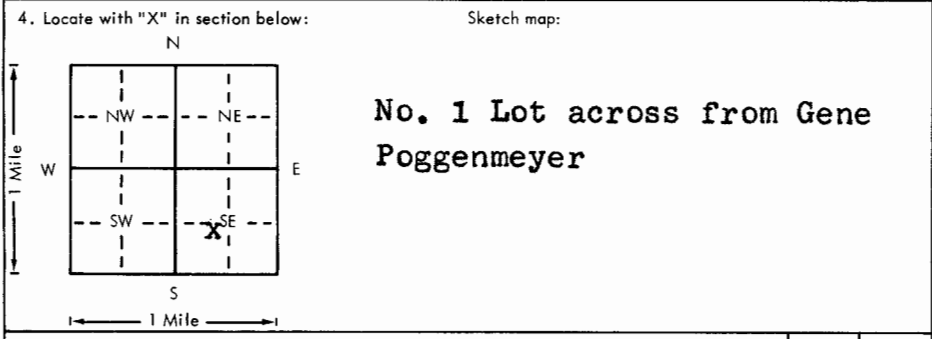

6. Bore hole dia. **8** in. Completion date **9-26-78**
 Well depth **140** ft.
 7. Cable tool Rotary Driven Dug
 Hollow rod Jetted Bored Reverse rotary
 8. Use: Domestic Public supply Industry
 Irrigation Air conditioning Stock
 Lawn Oil field water Other
 9. Casing: Material **RL** Height: Above or below
 Threaded Welded Surface **18** in.
 RMP PVC Weight _____ lbs./ft.
 Dia. **5** in. to **143** ft. depth Wall Thickness: inches or
 Dia. _____ in. to _____ ft. depth Gage No. _____

5. Type and color of material	From	To
Top Soil	0	3
Clay - Yellow	3	10
Clay - light	10	23
Blue Mud	23	35
Sand & Gravel	35	45
Drift	45	80
Sandy Shale	80	102
Blue Mud	102	113
Sandstone - Gray	113	133
Lime	133	140

(Use a second sheet if needed)

10. Screen: Manufacturer's name **XX (Slotted Pipe) Vinylplex, Inc.**
 Type **PVS** Dia. **5"**
 Slot/gauze **.06 1/16** Length **30'**
 Set between **110** ft. and **140** ft.
 _____ ft. and _____ ft.
 Gravel pack? Size range of material **1/4-1/8**
 11. Static water level: _____ mo./day/yr.
60 ft. below land surface Date **9-26-78**
 12. Pumping level below land surfaces:
 _____ ft. after _____ hrs. pumping _____ g.p.m.
 _____ ft. after _____ hrs. pumping _____ g.p.m.
 Estimated maximum yield **12** g.p.m.
 13. Water sample submitted: _____ mo./day/yr.
 Yes No Date _____
 14. Well head completion:
 Pitless adapter **18** Inches above grade
 15. Well grouted? **Yes**
 With: Neat cement Bentonite Concrete
 Depth: From **3** ft. to **15** ft.
 16. Nearest source of possible contamination:
 ft. **100'** Direction **east** Type **septic**
 Well disinfected upon completion? Yes No
 17. Pump: _____ Not installed
 Manufacturer's name **Jacuzzi**
 Model number **7S4B** HP **3/4** Volts **220**
 Length of drop pipe **130** ft. capacity **10** g.p.m.
 Type:
 Submersible Turbine
 Jet Reciprocating
 Centrifugal Other

18. Elevation: **972**
 Topography:
 Hill Slope
 Upland Valley

19. Remarks: *60' deep*
 20. Water well contractor's certification:
 This well was drilled under my jurisdiction and this report
 is true to the best of my knowledge and belief.
BREUER, INC. **174**
 Business name License No.
 Address **Box 147, Basehor, Ks.**
 Signed *Ralph A. Breuer* Date **10-6-78**
 Authorized Representative

Forward the white, blue and pink copies to the Department of Health and Environment

Form WWC-5

BR elev = 859 D = 912

T
R
W
E
S
E
1/4
1/4
1/4
1/4