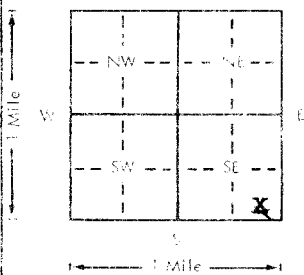


USE TYPEWRITER OR BALL POINT PEN-PRESS FIRMLY, PRINT CLEARLY.

WATER WELL RECORD
KSA 82a-1201-1215

Kansas Department of Health and Environment-Division of Environment
(Water well Contractors)
Topeka, Kansas 66620

1. Location of well:		County Leavenworth	Fraction SE 1/4 SE 1/4 SE 1/4	Section number 21	Township number T 10	Range number 22
2. Distance and direction from nearest town or city: 2 miles south and 1 mile west of Fairmount, Kansas			3. Owner of well: John Miller R.R. or street: Route 1, Box 31J City, state, zip code: Basehor, Kansas			
4. Locate with "X" in section below: Sketch map: 			6. Bore hole dia. 8 in. Completion date 5-23-79 Well depth 135 ft.			
5. Type and color of material:			7. <input type="checkbox"/> Cable tool <input checked="" type="checkbox"/> Rotary <input type="checkbox"/> Driven <input type="checkbox"/> Dug <input type="checkbox"/> Hollow rod <input type="checkbox"/> Jetted <input type="checkbox"/> Bored <input type="checkbox"/> Reverse rotary			
			8. Use: <input checked="" type="checkbox"/> Domestic <input type="checkbox"/> Public supply <input type="checkbox"/> Industry <input type="checkbox"/> Irrigation <input type="checkbox"/> Air conditioning <input type="checkbox"/> Stock <input type="checkbox"/> Lawn <input type="checkbox"/> Oil field water <input type="checkbox"/> Other			
			9. Casing: Material PL. Height: Above or below Threaded <input type="checkbox"/> welded <input checked="" type="checkbox"/> Surface 18 in. RMP <input type="checkbox"/> PVC <input checked="" type="checkbox"/> Weight <input type="checkbox"/> lbs./ft. Dia. 5 in. to 137 ft. depth Wall Thickness: inches or Dia. <input type="checkbox"/> in. to <input type="checkbox"/> ft. depth (gauge No. 265)			
			10. Screens: Manufacturer's name (Slotted Pipe Vinylplex, Inc.) Type PVC Dia. 5" Slot/gauze .06 1/16 Length 23' Set between 110 ft. and 133 ft. <input type="checkbox"/> ft. and <input type="checkbox"/> ft. Gravel pack? <input checked="" type="checkbox"/> Size range of material 1-4/1-8			
			11. Static water level: <input type="checkbox"/> mo./day/yr. 60 ft. below land surface Date 5-23-79			
			12. Pumping level below land surfaces: <input type="checkbox"/> ft. after <input type="checkbox"/> hrs. pumping <input type="checkbox"/> g.p.m. <input type="checkbox"/> ft. after <input type="checkbox"/> hrs. pumping <input type="checkbox"/> g.p.m. Estimated maximum yield over 12 g.p.m.			
			13. Water sample submitted: <input type="checkbox"/> mo./day/yr. Yes: <input checked="" type="checkbox"/> No: <input type="checkbox"/> Date			
			14. Well head completion: <input checked="" type="checkbox"/> Pitless adapter 18 inches above grade			
			15. Well grouted? Yes With: <input checked="" type="checkbox"/> Neat cement <input type="checkbox"/> Bentonite <input type="checkbox"/> Concrete Depth: From 3 ft. to 15 ft.			
			16. Nearest source of possible contamination: ft. 75' Direction SW Type Septic Well disinfected upon completion? <input checked="" type="checkbox"/> Yes <input type="checkbox"/> No			
			17. Pump: <input type="checkbox"/> Not installed Manufacturer's name Jacuzzi Model number 5S4B HP 1/2 Volts 220 Length of drop pipe 125 ft. capacity 10 g.p.m. Type: <input checked="" type="checkbox"/> Submersible <input type="checkbox"/> Turbine <input type="checkbox"/> Jet <input type="checkbox"/> Reciprocating <input type="checkbox"/> Centrifugal <input type="checkbox"/> Other			
16. Elevation:			20. Water well contractor's certification: This well was drilled under my jurisdiction and this report is true to the best of my knowledge and belief. BREUER, INC. 174 Business name License No. Address Box 147, Basehor, Ks. Signed <i>[Signature]</i> Date 5-23-79 Authorized representative			
19. Remarks:						
Topography: <input type="checkbox"/> Hill <input type="checkbox"/> Slope <input type="checkbox"/> Upland <input type="checkbox"/> Valley						