


USE TYPEWRITER OR BALL POINT PEN-PRESS FIRMLY, PRINT CLEARLY.

WATER WELL RECORD
KSA 82a-1201-1215

Kansas Department of Health and Environment-Division of Environment
(Water well Contractors)
Topeka, Kansas 66620

1. Location of well:	County Leavenworth	Fraction SE 1/4 NE 1/4 NE 1/4	Section number 22	Township number T 10 S R	Range number 22 E/W
----------------------	------------------------------	---	-----------------------------	------------------------------------	---

2. Distance and direction from nearest town or city: 2 miles north of Basehor, Kansas	3. Owner of well: Shirley Brandt R.R. or street: Basehor, Kansas City, state, zip code:
--	---

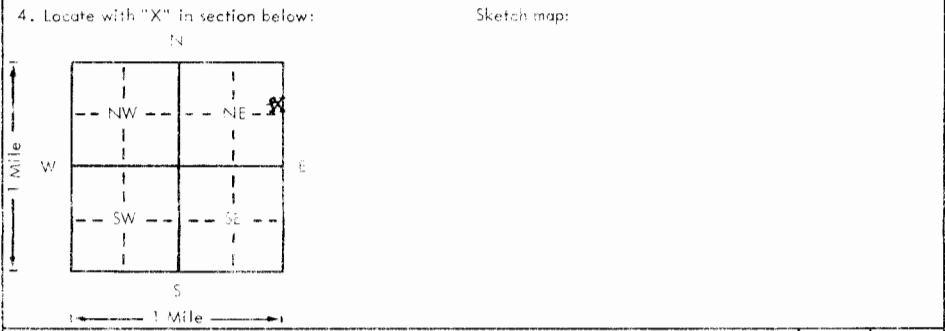

6. Bore hole dia. 8 in. Completion date 7-26-78
Well depth 140 ft.

7. Cable tool Rotary Driven Dug
 Hollow rod Jetted Bored Reverse rotary

8. Use: Domestic Public supply Industry
 Irrigation Air conditioning Stock
 Lawn Oil field water Other

9. Casing: Material Steel Height: Above or below
Threaded Welded Surface 18 in.
RMP PVC Weight _____ lbs./ft.
Dia. 6 in. to 122 ft. depth Wall Thickness: inches or
Dia. _____ in. to _____ ft. depth Gauge No. .188

5. Type and color of material	From	To
Top Soil	0	2
Clay	2	20
Sand & Gravel	20	36
Light Green Mud	36	46
Soft Sand (Caving)	46	70
Blue Mud	70	113
Sandstone - Gray	113	139
Lime	139	140

10. Screen: Manufacturer's name NONE
Type _____ Dia. _____
Slot/gauze _____ Length _____
Set between _____ ft. and _____ ft.
Gravel pack? NONE Size range of material _____

11. Static water level: 65 ft. below land surface Date 7-26-78 mo./day/yr.

12. Pumping level below land surfaces:
_____ ft. after _____ hrs. pumping _____ g.p.m.
_____ ft. after _____ hrs. pumping _____ g.p.m.
Estimated maximum yield 20 g.p.m.

13. Water sample submitted: _____ mo./day/yr.
 Yes No Date _____

14. Well head completion:
 Pitless adapter 18 Inches above grade

15. Well grouted? Yes
With: Neat cement Bentonite Concrete
Depth: From 3 ft. to 15 ft.

16. Nearest source of possible contamination:
ft. 100' Direction south Type septic
Well disinfected upon completion? Yes No

17. Pump: _____ Not installed
Manufacturer's name Jacuzzi
Model number 7S4B HP 3/4 Volts 220
Length of drop pipe 130 ft. capacity 10 g.p.m.
Type:
 Submersible Turbine
 Jet Reciprocating
 Centrifugal Other

(Use a second sheet if needed)

18. Elevation:	19. Remarks:
Topography: <input type="checkbox"/> Hill <input type="checkbox"/> Slope <input type="checkbox"/> Upland <input type="checkbox"/> Valley	

20. Water well contractor's certification:
This well was drilled under my jurisdiction and this report is true to the best of my knowledge and belief.
BREUER, INC. 174
Business name License No.
Address Box 147, Basehor, Ks.
Signed [Signature] Date 8-30-78