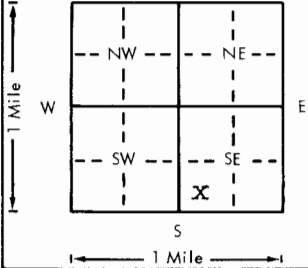


USE TYPEWRITER OR BALL POINT PEN-PRESS FIRMLY, PRINT CLEARLY.

WATER WELL RECORD
KSA 82a-1201-1215

Kansas Department of Health and Environment-Division of Environment
(Water well Contractors)
Topeka, Kansas 66620

1. Location of well:		County Leavenworth	Fraction SW 1/4 SW 1/4 SE 1/4	Section number 25	Township number T 10 S R 22	Range number 22
2. Distance and direction from nearest town or city: Street address of well location if in city: 1 mile east of Basehor, Kansas			3. Owner of well: R.R. or street: City, state, zip code:			
4. Locate with "X" in section below: N W E S 1 Mile			Sketch map: 		6. Bore hole dia. 8 in. Completion date 1-15-76 Well depth 100 ft.	
5. Type and color of material			From	To	7. <input checked="" type="checkbox"/> Cable tool <input checked="" type="checkbox"/> Rotary <input type="checkbox"/> Driven <input type="checkbox"/> Dug <input type="checkbox"/> Hollow rod <input type="checkbox"/> Jetted <input type="checkbox"/> Bored <input type="checkbox"/> Reverse rotary	
Top Soil			0	3	8. Use: <input checked="" type="checkbox"/> Domestic <input type="checkbox"/> Public supply <input type="checkbox"/> Industry <input type="checkbox"/> Irrigation <input type="checkbox"/> Air conditioning <input type="checkbox"/> Stock <input type="checkbox"/> Lawn <input type="checkbox"/> Oil field water <input type="checkbox"/> Other	
Sandstone - Yellow			3	38	9. Casing: Material PL Height: Above or below Threaded <input type="checkbox"/> Welded <input checked="" type="checkbox"/> Surface _____ in. RMP _____ PVC <input checked="" type="checkbox"/> Weight _____ lbs./ft. Dia. 5 in. to 40 ft. depth Wall Thickness: inches or Dia. _____ in. to _____ ft. depth gage No. 258WT	
Sandstone - Gray			38	40	10. Screen: Manufacturer's name NONE Type _____ Dia. _____ Slot/gauze _____ Length _____ Set between _____ ft. and _____ ft. _____ ft. and _____ ft. Gravel pack? No Size range of material _____	
Lime - White			40	50	11. Static water level: _____ mo./day/yr. 35 ft. below land surface Date 1-15-76	
Shale - Blue			50	55	12. Pumping level below land surfaces: _____ ft. after _____ hrs. pumping _____ g.p.m. _____ ft. after _____ hrs. pumping _____ g.p.m. Estimated maximum yield 2 g.p.m.	
Lime - White			55	66	13. Water sample submitted: _____ mo./day/yr. <input type="checkbox"/> Yes <input checked="" type="checkbox"/> No Date _____	
Shale - Blue			66	72	14. Well head completion: <input checked="" type="checkbox"/> Pitless adapter 18 Inches above grade	
Lime - Brown			72	76	15. Well grouted? Yes With: <input checked="" type="checkbox"/> Neat cement <input type="checkbox"/> Bentonite <input type="checkbox"/> Concrete Depth: From 3 ft. to 23 ft.	
Shale - Blue			76	95	16. Nearest source of possible contamination: ft. 350' Direction East Type Septic Well disinfected upon completion? <input checked="" type="checkbox"/> Yes <input type="checkbox"/> No	
Lime - White			95	100	17. Pump: _____ Not installed Manufacturer's name Jacuzzi Model number 5S4B HP 1/2 Volts 220 Length of drop pipe 40 ft. capacity 10 g.p.m. Type: <input checked="" type="checkbox"/> Submersible <input type="checkbox"/> Turbine <input type="checkbox"/> Jet <input type="checkbox"/> Reciprocating <input type="checkbox"/> Centrifugal <input type="checkbox"/> Other	
(Use a second sheet if needed)						
18. Elevation:		19. Remarks:		20. Water well contractor's certification:		
Topography: <input type="checkbox"/> Hill <input checked="" type="checkbox"/> Slope <input type="checkbox"/> Upland <input type="checkbox"/> Valley		Shot Well - 550 Gallons Storage		This well was drilled under my jurisdiction and this report is true to the best of my knowledge and belief. BREUER DRILLING COMPANY 174 Business name License No. _____ Address Box 147, Basehor, Ks. 66601 Signed Ralph N. Breuer Date 1-15-76 Authorized Representative		