USE TYPEWRITER OR BALL POINT PEN-PRESS FIRMLY, PRINT CLEARLY.

WATER WELL RECORD
KSA 82a-1201-1215

Kansas Department of Health and Environment-Division of Environment
(Water well Contractors)
Topeka, Kansas 66620

1. Location of well:	County	Fraction	Section number	Township number	Range number
	Leavenworth	NW 1/4 NE 1/4 NW 1/4	30	T 10 S	R 22 E/W

2. Distance and direction from nearest town or city: 4 miles west &
Street address of well location if in city: 2 miles north of Basehor, Kansas

3. Owner of well: Mr. Emil Seitter
R.R. or street: Route 3, Box 122D1
City, state, zip code: Tonganoxie, Kansas 66086

4. Locate with "X" in section below:

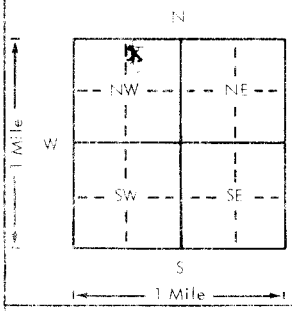

Sketch map:

6. Bore hole dia. 8 in. Completion date 3-18-80
Well depth 100 ft.

7. XX Cable tool __ Rotary __ Driven __ Dug
__ Hollow rod __ Jetted __ Bored __ Reverse rotary

8. Use: XX Domestic __ Public supply __ Industry
__ Irrigation __ Air conditioning __ Stock
__ Lawn __ Oil field water __ Other

9. Casing: Material PL. Height: Above or below
Threaded ____ Welded XX Surface ____ 18 in.
RMP ____ PVC XX Weight ____ lbs./ft.
Dia. 5 in. to 101 ft. depth Wall Thickness: inches or
Dia. ____ in. to ____ ft. depth gage No. .265

10. Screen: Manufacturer's name (Slotted Pipe
Vinylplex, Inc.
Type PVC Dia. 5"
Slot/gauze .06 1/16 Length 50'
Set between 20 ft. and 30 ft.
90 ft. and 100 ft.
Gravel pack? XX Size range of material 1/4 - 1/8

11. Static water level: mo./day/yr.
16 ft. below land surface Date 3-18-80

12. Pumping level below land surface:
____ ft. after ____ hrs. pumping ____ g.p.m.
____ ft. after ____ hrs. pumping ____ g.p.m.
Estimated maximum yield 3 g.p.m.

13. Water sample submitted: mo./day/yr.
__ Yes X No Date ____

14. Well head completion:
XX Pitless adapter 18 Inches above grade

15. Well grouted? Yes
With X Neat cement ____ Bentonite ____ Concrete
Depth: from 3 ft. to 15 ft.

16. Nearest source of possible contamination:
ft. 300' Direction NW Type Septic
Was disinfected upon completion? XX Yes ____ No

17. Pump: XX Not installed
Manufacturer's name ____
Model number ____ HP ____ Volts ____
Length of drop pipe ____ ft. capacity ____ g.p.m.
Type:
__ Submersible __ Turbine
__ Jet __ Reciprocating
__ Centrifugal __ Other

5. Type and color of material	From	To
Top Soil	0	6
Clay	6	16
Sandstone	16	32
Lime	32	61
Shale	61	82
Lime	82	100

(Use a second sheet if needed)

18. Elevation:
Topography:
____ Hill
____ Slope
____ Upland
____ Valley

19. Remarks:

20. Water well contractor's certification:
This well was drilled under my jurisdiction and this report is true to the best of my knowledge and belief.
BREUER, INC. 174
Business name License No.
Address Box 187, Basehor, Ks.
Signed [signature] Date 5-19-80
(Authorized representative)

Forward the white, blue and pink copies to the Department of Health and Environment

Form WWC-5