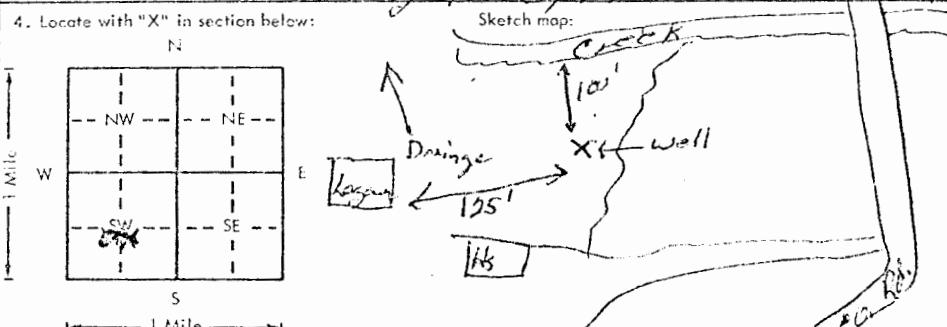


USE TYPEWRITER OR BALL POINT PEN-PRESS FIRMLY, PRINT CLEARLY.

WATER WELL RECORD
KSA 82a-1201-1215

Kansas Department of Health and Environment-Division of Environment
(Water well Contractors)
Topeka, Kansas 66620

1. Location of well: County <u>Leavenworth</u> Fraction <u>NW 1/4 SE 1/4 SW 1/4</u> Section number <u>32</u> Township number <u>T 10 S R 22</u> Range number <u>22</u> <u>EW</u>	
2. Distance and direction from nearest town or city: <u>4 1/2 E - 1 1/4 N</u> Street address of well location if in city: <u>Tonganoxie, Ks</u> 3. Owner of well: <u>Jerald Cooper</u> R.R. or street: <u>RR#3 Box 109 A</u> City, state, zip code: <u>Tonganoxie, Ks 66606</u>	
4. Locate with "X" in section below: 	
5. Type and color of material	
	From To
<u>Black loam</u>	<u>0 10</u>
<u>Black Sandy loam</u>	<u>10 19</u>
<u>Black loam</u>	<u>19 22</u>
<u>Gray Med. Sand to 1 X 1/2 Chert Gravel</u>	<u>22 27</u>
<u>Gray Sandstone</u>	<u>27 33</u>
<u>Gray Shale</u>	<u>33 37</u>
<u>Gray limestone</u>	<u>37 50</u>
<u>Gray Shale</u>	<u>50 56</u>
<u>Gray Shaly SS.</u>	<u>56 62</u>
<u>Brown Shale</u>	<u>62 66</u>
<u>Gray Shale</u>	<u>66 78</u>
<u>Brown limestone</u>	<u>78 80</u>
(Use a second sheet if needed)	
18. Elevation: Topography: <input type="checkbox"/> Hill <input type="checkbox"/> Slope <input type="checkbox"/> Upland <input checked="" type="checkbox"/> Valley	19. Remarks: <u>owner to install slab</u>
20. Water well contractor's certification: This well was drilled under my jurisdiction and this report is true to the best of my knowledge and belief. Business name: <u>Stoner Dalg Co</u> License No. <u>182</u> Address: <u>RT1 Holton, Ks</u> Signed: <u>Dale Rubin</u> Date: <u>8-22-78</u> Authorized representative	