255

R

USE TYPEWRITER OR BALL POINT PEN-PRESS FIRMLY, PRINT CLEARLY.

WATER WELL RECORD
KSA 82a-1201-1215

AAB

Kansas Department of Health and Environment-Division of Environment
(Water well Contractors)
Topeka, Kansas 66620

1. Location of well:	County	Fraction	Section number	Township number	Range number
	Leavenworth	NW 1/4 NE 1/4 NE 1/4	32	T 10 S	R 22 E/W

2. Distance and direction from nearest town or city:
Street address of well location if in city: 2½ Mile west of Bashor

3. Owner of well: A.W. Derringer
R.R. or street: R.R. 2
City, state, zip code: Tonganoxie KS 66086

4. Locate with "X" in section below:

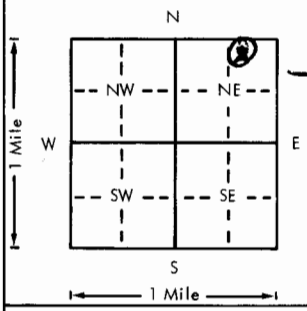

Sketch map:

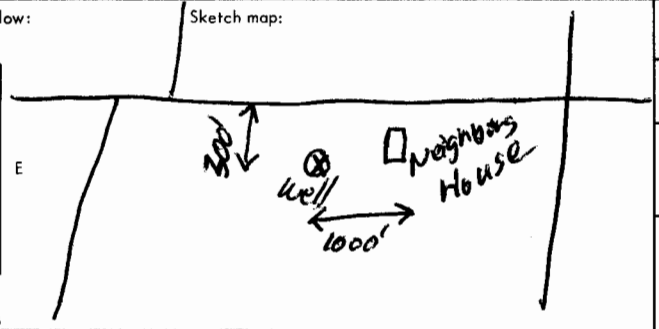

6. Bore hole dia. 7 3/8 in. Completion date
Well depth 100 ft. 10-16-79

7. __ Cable tool X Rotary __ Driven __ Dug
__ Hollow rod __ Jetted __ Bored __ Reverse rotary

8. Use: X Domestic __ Public supply __ Industry
__ Irrigation __ Air conditioning __ Stock
__ Lawn __ Oil field water __ Other

9. Casing: Material
Threaded __ Welded X
RMP __ PVC X
Dia. 5 in. to 100 ft. depth
Dia. __ in. to __ ft. depth
Height: Above or below Surface 12 in.
Weight 1.65 lbs./ft.
Wall Thickness: inches or gage No. Sch 200

5. Type and color of material	From	To
Surface	0	1
Yellow Clay	1	16
Shale Blue	16	32
Coal Black (water)	32	35
Shale Gray	35	56
Sandstone Gray	56	108
Limestone white	108	118
Shale Gray	118	123
Limestone Gray	123	127
Shale Gray	127	141
[illegible]		
[illegible]		
(Use a second sheet if needed)		

10. Screen: Manufacturer's name Jess & Lowe
Type Plastic Dia. 5"
Slot/gauze 1/16" Length 20
Set between 70 ft. and 90 ft.
ft. and ft.
Gravel pack? Yes Size range of material 1/4 X 1/8"

11. Static water level: 25 ft. below land surface Date (mo./day/yr.) 10-16-79

12. Pumping level below land surfaces:
ft. after hrs. pumping g.p.m.
ft. after hrs. pumping g.p.m.
Estimated maximum yield 3 g.p.m.

13. Water sample submitted: (mo./day/yr.)
__ Yes X No Date

14. Well head completion:
X Pitless adapter 12 Inches above grade

15. Well grouted? Yes
With: X Neat cement __ Bentonite __ Concrete
Depth: From 15 ft. to 5 ft.

16. Nearest source of possible contamination: Septic
ft. 1000 Direction East Type
Well disinfected upon completion? X Yes __ No

17. Pump: X Not installed
Manufacturer's name
Model number HP Volts
Length of drop pipe ft. capacity g.p.m.
Type:
__ Submersible __ Turbine
__ Jet __ Reciprocating
__ Centrifugal __ Other

T 10 R 22 E/W Sec 32 1/4 NW 1/4 NE 1/4

18. Elevation: ~~1030~~ 922
Topography:
X Hill
__ Slope
__ Upland

19. Remarks:
Customer is aware of state regulation to install a 4 ft. square concrete platform around well.
see attached Note

customer is aware of state regulation requiring 4' square concrete platform around well and agrees to install same.
A.W. Derringer

20. Water well contractor's certification:
This well was drilled under my jurisdiction and this report is true to the best of my knowledge and belief.
Business name F.E. Young Drilling Co. License No. 240
Address 6355 Robinhood Merriam
Signed David Young Date 11-5-79
Authorized representative

BR = 906
E = 817

Form WWC-5

MI-1023