


1 LOCATION OF WATER WELL: County: Leavenworth Fraction: NE 1/4 ~~SE 1/4~~ ~~SE 1/4~~ Section Number: 33 Township Number: T 10 S Range Number: R 22 E/W

Distance and direction from nearest town or city street address of well if located within city?

1/2 mile west of Basehor

2 WATER WELL OWNER: McDowell Kennels RR#, St. Address, Box #: Basehor, KS 66007 City, State, ZIP Code: Basehor, KS 66007 Board of Agriculture, Division of Water Resources Application Number: _____

3 LOCATE WELL'S LOCATION WITH AN "X" IN SECTION BOX:

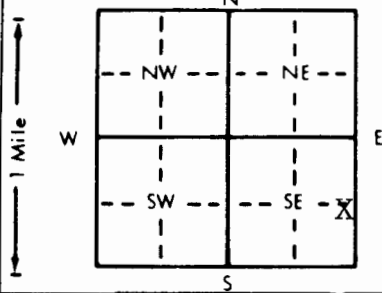

4 DEPTH OF COMPLETED WELL: 78 ft. ELEVATION: _____

Depth(s) Groundwater Encountered: 1. 48 ft. 2. _____ ft. 3. _____ ft.

WELL'S STATIC WATER LEVEL: 34 ft. below land surface measured on 6-10-92 mo/day/yr

Pump test data: Well water was _____ ft. after _____ hours pumping _____ gpm

Est. Yield: 8 gpm: Well water was _____ ft. after _____ hours pumping _____ gpm

Bore Hole Diameter: 12 in. to 48 ft., and 8 in. to 78 ft.

WELL WATER TO BE USED AS: #1 5 Public water supply 8 Air conditioning 11 Injection well

1 Domestic 3 Feedlot 6 Oil field water supply 9 Dewatering 12 Other (Specify below)

2 Irrigation 4 Industrial 7 Lawn and garden only 10 Monitoring well

Was a chemical/bacteriological sample submitted to Department? Yes _____ No _____ If yes, mo/day/yr sample was submitted _____

Water Well Disinfected? Yes No _____

5 TYPE OF BLANK CASING USED: 5 Wrought iron 8 Concrete tile CASING JOINTS: Glued Clamped _____

1 Steel 3 RMP (SR) 6 Asbestos-Cement 9 Other (specify below) Welded _____

2 PVC 4 ABS 7 Fiberglass Threaded _____

Blank casing diameter: 5 in. to 44 ft. Dia: ~~54~~ 5 in. to ~~78~~ 76 ft. Dia: _____ in. to _____ ft.

Casing height above land surface: 30 in. weight: 285 lbs./ft. Wall thickness or gauge No. 265

TYPE OF SCREEN OR PERFORATION MATERIAL: #7 7 PVC 10 Asbestos-cement

1 Steel 3 Stainless steel 5 Fiberglass 8 RMP (SR) 11 Other (specify) _____

2 Brass 4 Galvanized steel 6 Concrete tile 9 ABS 12 None used (open hole)

SCREEN OR PERFORATION OPENINGS ARE: #3 5 Gauzed wrapped 8 Saw cut 11 None (open hole)

1 Continuous slot 3 Mill slot 6 Wire wrapped 9 Drilled holes

2 Louvered shutter 4 Key punched 7 Torch cut 10 Other (specify) _____

SCREEN-PERFORATED INTERVALS: From 44 ft. to 54 ft. From _____ ft. to _____ ft.

From 76 ft. to 78 ft. From _____ ft. to _____ ft.

GRAVEL PACK INTERVALS: From 24 ft. to 78 ft. From _____ ft. to _____ ft.

From _____ ft. to _____ ft. From _____ ft. to _____ ft.

6 GROUT MATERIAL: 3 Neat cement 2 Cement grout Bentonite 4 Other _____

Grout Intervals: From 4 ft. to 24 ft. From _____ ft. to _____ ft. From _____ ft. to _____ ft.

What is the nearest source of possible contamination? #1 10 Livestock pens 14 Abandoned water well

1 Septic tank 4 Lateral lines 7 Pit privy 11 Fuel storage 15 Oil well/Gas well

2 Sewer lines 5 Cess pool 8 Sewage lagoon 12 Fertilizer storage 16 Other (specify below)

3 Watertight sewer lines 6 Seepage pit 9 Feedyard 13 Insecticide storage

Direction from well? SW How many feet? 298

FROM	TO	LITHOLOGIC LOG	FROM	TO	PLUGGING INTERVALS
0	1	Top soil			
1	39	Clay-Brown			
39	48	Clay-Blue			
48	49	FS-CS-MED-GRAVEL			
49	74	Shale-grey			
74	78	Limestone-Grey			

7 CONTRACTOR'S OR LANDOWNER'S CERTIFICATION: This water well was (1) constructed, (2) reconstructed, or (3) plugged under my jurisdiction and was completed on (mo/day/year) #1 6-10-92 and this record is true to the best of my knowledge and belief. Kansas Water Well Contractor's License No. 174 This Water Well Record was completed on (mo/day/yr) 6-15-92 under the business name of Breuer Inc. by (signature) _____

John S. Breuer