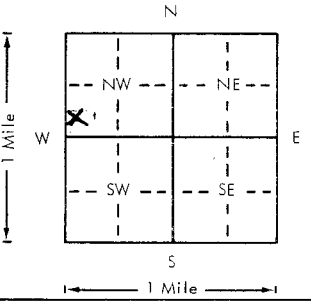
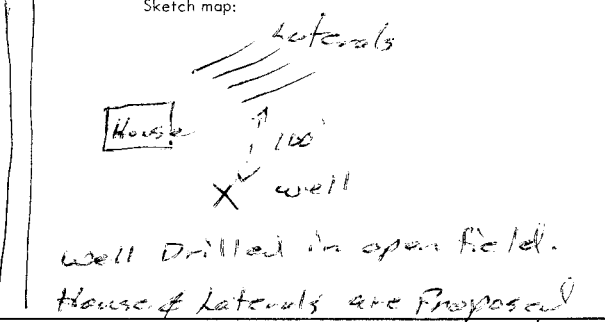


USE TYPEWRITER OR BALL POINT PEN-PRESS FIRMLY, PRINT CLEARLY.

WATER WELL RECORD
KSA 82a-1201-1215

Kansas Department of Health and Environment-Division of Environment (Water well Contractors)
Topeka, Kansas 66620

BCC

1. Location of well:	County: <u>Leavenworth</u>	Fraction: <u>SW 1/4 SW 1/4 NW 1/4</u>	Section number: <u>33</u>	Township number: <u>T 10 S</u>	Range number: <u>R 22 EW</u>
2. Distance and direction from nearest town or city: <u>2 W 1/2 S</u> Street address of well location if in city: <u>Basehor</u>			3. Owner of well: <u>Frank Bentley</u> R.R. or street: <u>6300 W. 62nd.</u> City, state, zip code: <u>Mission, KS 66202</u>		
4. Locate with "X" in section below: 			Sketch map: 		
5. Type and color of material			6. Bore hole dia. <u>8</u> in. Completion date <u>5-13-77</u> Well depth <u>156</u> ft.		
			7. <input type="checkbox"/> Cable tool <input checked="" type="checkbox"/> Rotary <input type="checkbox"/> Driven <input type="checkbox"/> Dug <input type="checkbox"/> Hollow rod <input type="checkbox"/> Jetted <input type="checkbox"/> Bored <input type="checkbox"/> Reverse rotary		
			8. Use: <input checked="" type="checkbox"/> Domestic <input type="checkbox"/> Public supply <input type="checkbox"/> Industry <input type="checkbox"/> Irrigation <input type="checkbox"/> Air conditioning <input type="checkbox"/> Stock <input type="checkbox"/> Lawn <input type="checkbox"/> Oil field water <input type="checkbox"/> Other		
			9. Casing: Material <u>PVC</u> Height <u>Above or below</u> Threaded <input type="checkbox"/> Welded <input type="checkbox"/> Surface <u>2 1/2</u> in. RMP <input type="checkbox"/> PVC <u>celluc</u> Weight <u>2.75</u> lbs./ft. Dia. <u>5</u> in. to <u>156</u> ft. depth Wall thickness: inches or Dia. <u> </u> in. to <u> </u> ft. depth gage No. <u>258</u>		
			10. Screen: Manufacturer's name <u>Pumpco</u> Type <u>PVC</u> Dia. <u>5</u> " Slot/gauze <u>000</u> Length <u>20</u> Set between <u>28</u> ft. and <u>48</u> ft. Gravel pack? <input checked="" type="checkbox"/> Size range of material: <u>0.075-0.60</u>		
			11. Static water level: <u>33</u> ft. below land surface Date <u>5-13-77</u> mo./day/yr.		
			12. Pumping level below land surfaces: <u>Air rest</u> <u> </u> ft. after <u> </u> hrs. pumping <u> </u> g.p.m. <u> </u> ft. after <u> </u> hrs. pumping <u> </u> g.p.m. Estimated maximum yield <u>25-30</u> (P.O.H.) g.p.m.		
			13. Water sample submitted: <u> </u> mo./day/yr. <input type="checkbox"/> Yes <input checked="" type="checkbox"/> No Date <u> </u>		
			14. Well head completion: <u>cap top</u> <input type="checkbox"/> Pitless adapter <u>24</u> inches above grade		
			15. Well grouted? <u>Yes</u> With: <input checked="" type="checkbox"/> Neat cement <input type="checkbox"/> Bentonite <input type="checkbox"/> Concrete Depth: From <u>5</u> ft. to <u>15</u> ft.		
			16. Nearest source of possible contamination: <u>Proposed</u> ft. <u>100</u> Direction <u>NE</u> Type <u>laterals</u> Well disinfected upon completion? <input checked="" type="checkbox"/> Yes <input type="checkbox"/> No		
			17. Pump: <input checked="" type="checkbox"/> Not installed Manufacturer's name <u> </u> Model number <u> </u> HP <u> </u> Volts <u> </u> Length of drop pipe <u> </u> ft. capacity <u> </u> g.p.m. Type: <input type="checkbox"/> Submersible <input type="checkbox"/> Turbine <input type="checkbox"/> Jet <input type="checkbox"/> Reciprocating <input type="checkbox"/> Centrifugal <input type="checkbox"/> Other		
18. Elevation: <u>898</u> Topography: <input checked="" type="checkbox"/> Hill <input type="checkbox"/> Slope <input type="checkbox"/> Upland <input type="checkbox"/> Valley			19. Remarks: <u>owner will construct cement slab around well.</u>		
			20. Water well contractor's certification: This well was drilled under my jurisdiction and this report is true to the best of my knowledge and belief. <u>STRODGER PUMP & SOIL INC 182</u> Business name License No. <u> </u> Address <u>RT 1 HOLTON, KS</u> Signed <u>Gay Johnson</u> Date <u>5-14-77</u> Authorized representative		