


USE TYPEWRITER OR BALL POINT PEN—PRESS FIRMLY, PRINT CLEARLY.

WATER WELL RECORD
KSA 82a-1201-1215

Kansas Department of Health and Environment—Division of Environment
(Water well Contractors)
Topeka, Kansas 66620

1. Location of well: County **Leavenworth** Fraction **SE 1/4 NE 1/4 SE 1/4** Section number **35** Township number **T 10 S 1 P 22** Range number **22** (EW)

2. Distance and direction from nearest town or city: **k 1 mile east of Basehor, Kansas**
3. Owner of well: **Mr. Charles Hobbs**
Street address of well location if in city: **Route 1**
R.R. or street:
City, state, zip code: **Basehor, Kansas 66007**

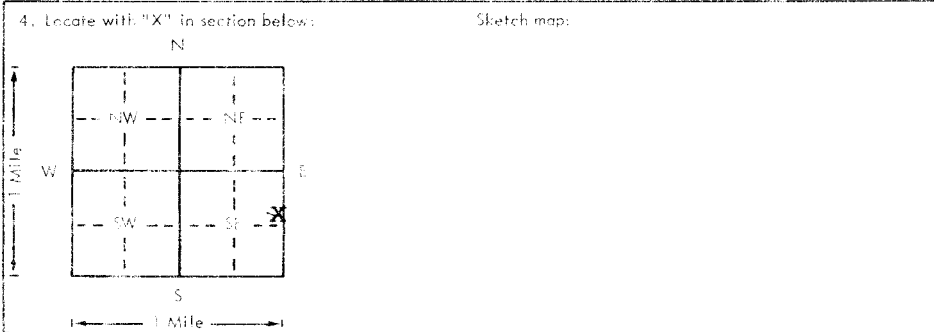

4. Bore hole dia. **8** in. Completion date **5-1-79**
Well depth **100** ft.
5. Cable tool Rotary Driven Dug
 Hollow rod Jetted Bored Reverse rotary
6. Use: Domestic Public supply Industry
 Irrigation Air conditioning Stock
 Lawn Oil field water Other
7. Casing: Material **P1.** Height: Above or below
Threaded Welded Surface **18** in.
RMP PVC Weight _____ lbs./ft.
Dia. **5** in. **101** ft. depth Wall thickness: inches or
Dia. _____ in. to _____ ft. depth gage No. **.265**

5. Type and color of material	From	To
Top Soil	0	5
Clay	5	11
Sand	11	17
Sandstone	17	53
Lime	53	58
Shale	58	64
Lime	64	78
Shale	78	83
Lime	83	88
Shale	88	100

10. Screen: Manufacturer's name **Slotted Pipe Vinylplex, Inc.**
Type **PVC** Dia. **5"**
Slot/gauge **.06 1/16** Length **40'**
Set between **40** ft. and **60** ft.
80 ft. and **100** ft.
Gravel pack? Size range of material: **1/4 - 1/8**
11. Static water level: _____ mo./day/yr.
27 ft. below land surface Date **5-1-79**
12. Pumping level below land surfaces:
_____ ft. after _____ hrs. pumping _____ g.p.m.
_____ ft. after _____ hrs. pumping _____ g.p.m.
Estimated maximum yield **3** _____ g.p.m.
13. Water sample submitted: _____ mo./day/yr.
Yes No Date _____
14. Well head completion:
 Pitless adapter **18** Inches above grade
15. Well grouted? **Yes**
With: Neat cement Bentonite Concrete
Depth: From **3** ft. to **12** ft.
16. Nearest source of possible contamination:
ft. **300** direction **NE** Type **Septic**
Well disinfected upon completion Yes No
17. Pump: _____ Not installed
Manufacturer's name **Jacuzzi**
Model number **5S4B** HP **1/2** Volts **220**
Length of drop pipe **90** ft. capacity **10** g.p.m.
Type:
 Submersible Turbine
 Jet Reciprocating
 Centrifugal Other

18. Elevation: _____
19. Remarks:
Topography:
____ Hill
____ Slope
____ Upland
____ Valley

20. Water well contractor's certification:
This well was drilled under my jurisdiction and this report is true to the best of my knowledge and belief.
BREUER, INC. 174
Business name License No. _____
Address **Box 147, Basehor, Ks.**
Signed *[Signature]* Date **5-7-79**
Authorized representative