

WATER WELL RECORD

DRILLERS LOG OF WELL

FROM (FT.)	TO (FT.)	KIND OF MATERIAL, COLOR, ETC. (NOTE WATER ZONES, AMOUNT, QUALITY)
0	1	Top Soil
1	31	Clay Sandstone
31	36	Blue Mud
36	41	Sandstone (Yellow)
41	50	Sandstone & Shale
50	98	Sandstone...
98	107	Sandy Shale
107	110	Lime T.D. 110 ft.

Well Owner Jack Kraft
 Address Fairmount, Kansas
 Drilling Contractor Breuer Drilling Co.
Box 147, Basehor, Kansas
 Date Drilled Nov, 16, 1960
 Method of Drilling Cable Tools
 (Cable tool, rotary, reverse rotary, etc.)
 Casing Schedule None
 (Amount, Size, Setting—New, Used—Steel, Galv.—Gage or Weight)

Screen Data (if any): _____
 (Length, Diameter, Slot Size, Setting)

Measured depth to water on completed well (Static Level) is
50 ft. below Land Surface
 (Land Surface, Top of Casing, Etc.)


TESTED YIELD: 10 gallons per Hour
 (Min., Hour)
 as determined by Bailing
 (Bailing, Test Pumping, Etc.)

DRAWDOWN: _____ ft. after _____ hrs.
 pumping at _____ gal. per minute.

REMARKS: confirmed location

DDA

LOCATION OF WELL Topographic Sheet Booby
 [Show location in Section Plat] Elev. 940
NE-SE x SE x Sec. 2
 T. 10 S., R. 22 E. W.
 County Beau
 BR = 904

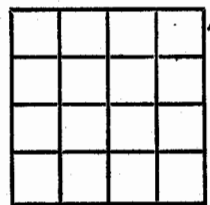

"To preserve water well information and to promote the conservation, protection, and development of ground-water resources."

Record by Kleinschmidt Date: 4-6-73 Project: Top-KC State: Kans K County: Leav 52

Latitude: _____ Longitude: _____ Accuracy: _____ Owner's well no: _____

Location: NE SE SE no. sec. 2, T. 10 N., R. 22 E. Well number: 1022E 2DDA

Owner: Jack Kraft name address Fairmont

Owner: JACK KRAFT Altitude 945 Accuracy 3

Driller: Breuer name address Date drilled: Nov-18-80

Topography, well site: (D) (F) (L) (R) (S) (T) (U) _____ Spring; or depth of well: 110 110 3

Diameter: None inches or feet _____ Depth cased: 0 feet _____ Spring, or Csg. type: _____ Finish: _____ Lift & power: _____

Pump setting: _____ Use of well: Domestic, stock, irrigation, industrial, public supply, observation, none, test _____

Water level: None above _____ below _____ date measured _____ Water level records avail. _____

Description MP: None (Dry) above _____ below _____

Yield: _____ gpm _____ accuracy _____ Pumping period: _____ hours or days _____ Specific capacity: _____ gpm/ft. dd _____

Pumpage and other data available: _____

Coefficient trans: _____ gpd/ft _____ Coefficient storage: _____ Coefficient perm.: _____ gpd/ft²

Aquifer, system or series _____ Aquifer, units _____

Aquifer, thickness: _____ feet _____ Aquifer, length of well open to: _____ feet _____ Aquifer, depth to top of: _____ feet _____ Aquifer, origin: _____

Aquifer, lithology of: _____ Bedrock, system: _____ Bedrock, formation: _____ Bedrock, depth to: _____ feet _____

Surficial material: _____ lithology _____ infiltration characteristics _____ Log data avail: Drillers log _____

Quality of water data available: _____ Temperature of water: _____ °F. _____ Date sampled: _____

Coefficient of leakage _____

THE FOLLOWING DATA ARE USED ON THE NATIONAL WELL SCHEDULE

Ownership category: (C) County, (F) Federal Gov't., (M) City, (N) Corp. or Co., (P) Private, (S) State Agency, (W) Water Dist. _____

Method drilled: (A) Air, (B) bored, (C) cable, (D) dug, (V) driven, (H) hyd. rotary, (J) jetted, (R) rev. rotary, (T) trenching, (S) spring, _____

Physiographic province: _____ Section: _____



Drainage basin: _____ Subbasin: _____ Depth to basement: _____ source of data (basement) _____

Quadrangle _____


Well no. _____

Co Road

x power poles x

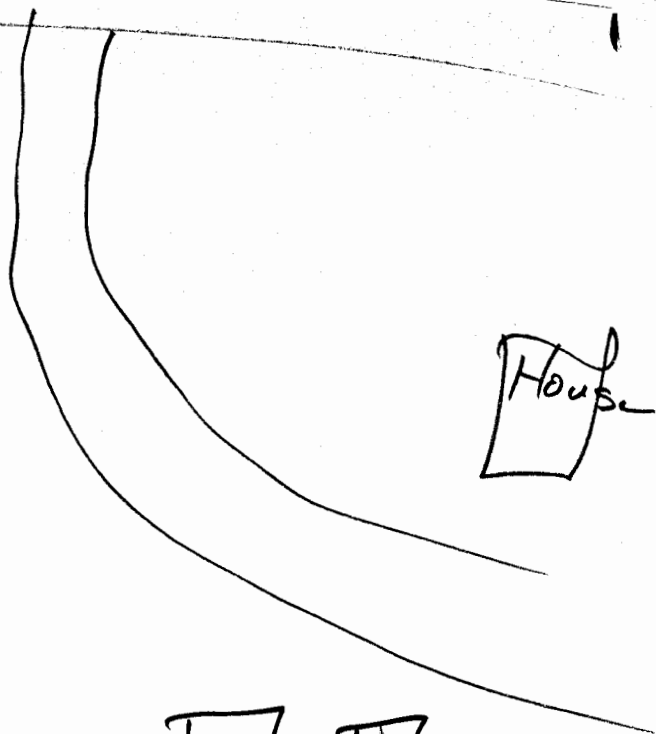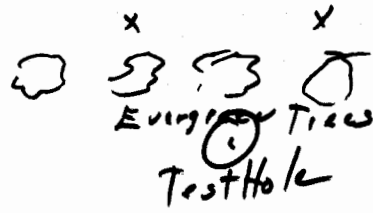

House

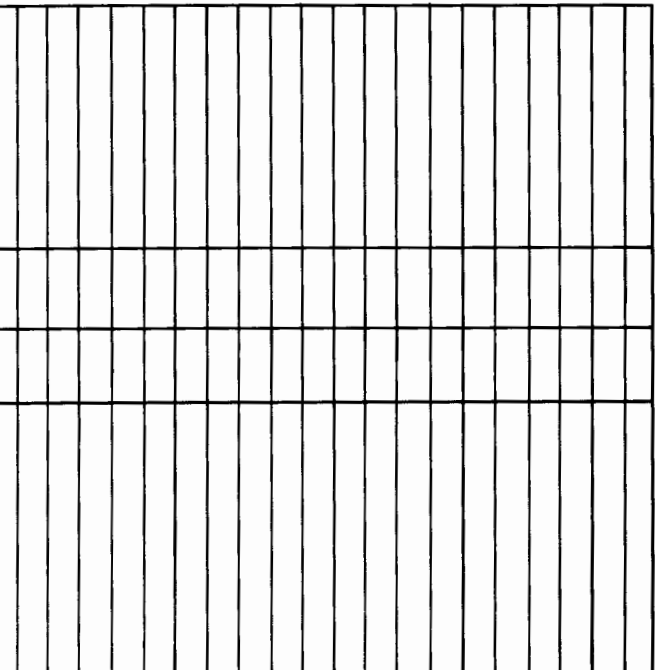

general slope is toward
← Road is higher than House Base →

