


USE TYPEWRITER OR BALL POINT PEN-PRESS FIRMLY, PRINT CLEARLY.

WATER WELL RECORD
KSA 82a-1201-1215

Kansas Department of Health and Environment
Division of Environment
(Water well Contractors)
Topeka, Kansas 66620

1. Location of well: County Leavenworth Fraction SW SW SW Section number 30 80 Township number T 10 S R 22 Range number 22 (E/W)

2. Distance and direction from nearest town or city: 2 miles north & 4 miles west of Basehor
Street address of well location if in city: _____
3. Owner of well: Mr. Frank DeGraves
R.R. or street: Route 3
City, state, zip code: Tonganoxie, Kansas

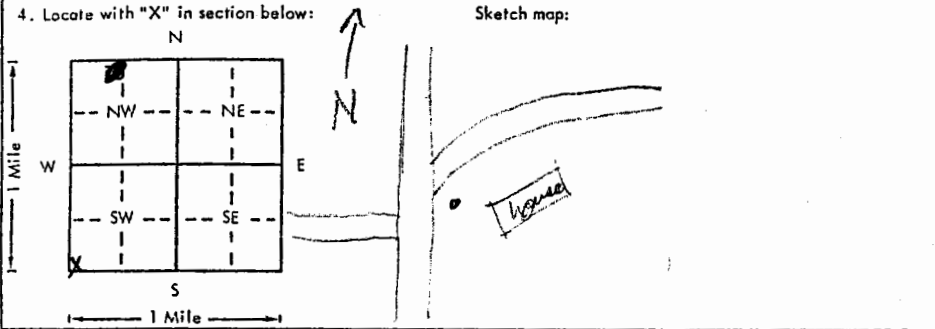

6. Bore hole dia. 8 in. Completion date 11-22-77
Well depth 132 ft.
7. Cable tool Rotary Driven Dug
 Hollow rod Jetted Bored Reverse rotary
8. Use: Domestic Public supply Industry
 Irrigation Air conditioning Stock
 Lawn Oil field water Other
9. Casing: Material PLC Height: Above or below
Threaded Welded Surface 18 in.
RMP PVC Weight _____ lbs./ft.
Dia. 5 in. to 133 ft. depth Wall Thickness: inches or
Dia. _____ in. to _____ ft. depth gage No. 265

5. Type and color of material	From	To
Top Soil	0	2
Sandy Clay	2	23
Sandstone	23	40
Shale	40	47
Light Gravel - Dry	47	52
Sandstone	52	113
Lime	113	132
(Use a second sheet if needed)		

10. Screen: Manufacturer's name (Slotted Pipe) Vinylplex, Inc.
Type PVC Dia. 5"
Slot/gauze 06 1/16 Length 40'
Set between 72 ft. and 112 ft.
_____ ft. and _____ ft.
Gravel pack? Size range of material 1/4 - 1/8
11. Static water level: _____ mo./day/yr.
95 ft. below land surface Date 11-22-77
12. Pumping level below land surfaces:
_____ ft. after _____ hrs. pumping _____ g.p.m.
_____ ft. after _____ hrs. pumping _____ g.p.m.
Estimated maximum yield 6 g.p.m.
13. Water sample submitted: _____ mo./day/yr.
Yes No Date _____
14. Well head completion:
 Pitless adapter 18 Inches above grade
15. Well grouted? Yes
With: Neat cement Bentonite Concrete
Depth: From 3 ft. to 15 ft.
16. Nearest source of possible contamination:
ft. 150 Direction south Type septic
Well disinfected upon completion? Yes No
17. Pump: Not installed
Manufacturer's name _____
Model number _____ HP _____ Volts _____
Length of drop pipe _____ ft. capacity _____ g.p.m.
Type:
 Submersible Turbine
 Jet Reciprocating
 Centrifugal Other

18. Elevation: 913
Topography: _____
 Hill
 Slope
 Upland
 Valley

19. Remarks: 947 from map
Rm

20. Water well contractor's certification:
This well was drilled under my jurisdiction and this report is true to the best of my knowledge and belief.
BREUER, INC. 174
Business name License No.
Address Box 147, Basehor, Ks. 66007
Signed [Signature] Date 11/25/77
Authorized representative

BR elev = 911 593