

not in CF

KANSAS WELL SCHEDULE

Card 1

Record by: Kleinschmidt 4-13-73 Date: 4-13-73 Project: Top-KC State: Kan County: Leaw 52

Latitude: _____ Longitude: _____ Accuracy: _____ Owner's well no: _____

Location: SE SE no. sec. 27, T. 10 N., R. 22 E. Well number: 1022E27DD

Owner: Raymond G Barber Barber

Owner: RAYMOND G BARBER Altitude: _____ Accuracy _____

Driller: Brewer Drilling Date drilled: _____

Topography, well site: (D) Draw, (F) flood plain, (L) lowland, (R) rolling, (S) slope, (T) terrace, (U) upland (D) Spring; or depth of well: _____ feet _____ accuracy _____

Diameter: 6.3 inches _____ Depth cased: _____ feet _____ Spring, or Csg. type: stair/S Finish: _____ Lift & power: _____

Pump setting: _____ Use of well: Domestic, stock, irrigation, industrial, public supply, observation, none, test (D)

Water level: 52.1 above lsd 521 M 1 4-13 D73 Water level records avail. _____

Description MP: Top Casing 3.0 below Yard in Box _____

Yield: 1.5 gpm _____ Pumping period: _____ Specific capacity: _____

Pumpage and other data available: _____

Card 2

Coefficient trans: _____ Coefficient storage: _____ Coefficient perm.: _____

Aquifer, system or series _____

Aquifer, units _____

Aquifer, thickness: _____ Aquifer, length of well open to: _____ Aquifer, depth to top of: _____ Aquifer, origin: _____

Aquifer, lithology of: _____

Bedrock, system: _____ Bedrock, formation: _____ Bedrock, depth to: _____

Surficial material: _____ Log data avail: Drillers log _____

Quality of water data available: _____ Temperature of water: _____ Date sampled: _____

Coefficient of leakage _____

Ownership category: _____ (P) Private _____ (P)


Method drilled: _____ (C) cable _____ (C)

Physiographic province: _____ Section: _____

Drainage basin: _____ Subbasin: _____ Depth to basement: _____ source of data (basement) _____



Quadrangle _____ Well no. _____

55.0
2.9
52.1

 

North

Draw sheet

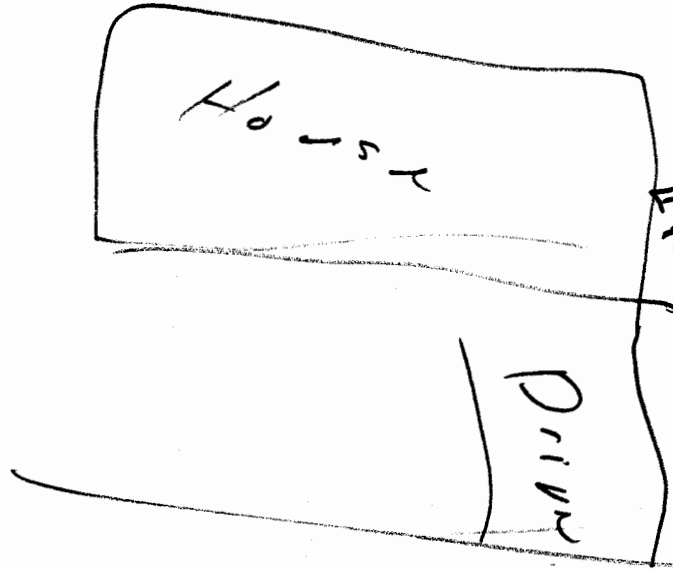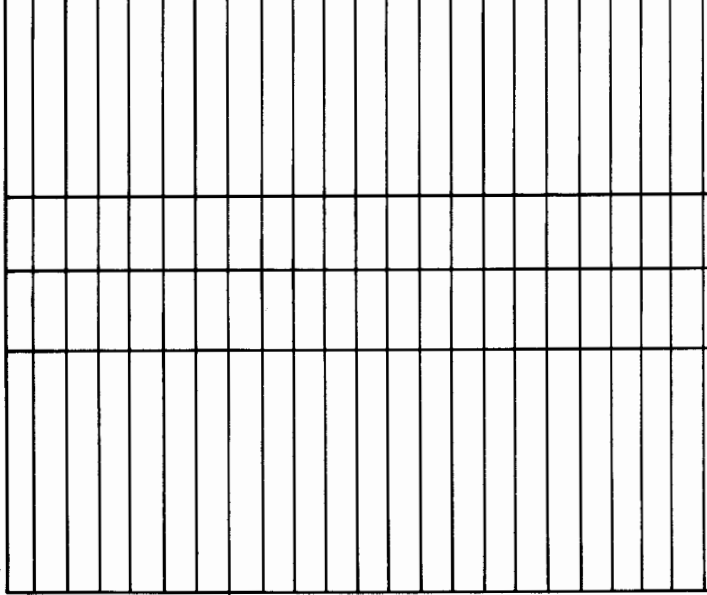

Lady as Keda boat of casing
water in Box at Top of casing

Baslor street