

BRT
 Top Kansas Map

WATER WELL RECORD

DRILLERS LOG OF WELL

FROM (FT.)	TO (FT.)	KIND OF MATERIAL, COLOR, ETC. (NOTE WATER ZONES, AMOUNT, QUALITY)
		Test No 1 elev 922 ± 3
0	3	Top Soil ccc BR 907
3	15	Clay
15	54	Sandstone Soft 10 G. P. M.
54	65	Lime
65	70	Shale
70	72	shale R2*
72	75	Shale T. D. 75 ft.
		Test No 2 elev 910 ± 3
0	3	Top Soil CCP BR 880
3	15	Clay
15	30	Sandy Clay
30	42 1/2	Sandstone Yellow
42 1/2	74	Sandstone Gray 15 G.P.M.
74	85	Lime
85	90	Shale
90	95	Lime
95	100	Shale T. D. 100 ft.


Well Owner Water Dis No. 4
 Address Basehor, Kansas
 Drilling Contractor Brauer Drilling
Basehor, Kansas
 Date Drilled March 1972
 Method of Drilling Air-Rotary
 (Cable tool, rotary, reverse rotary, etc.)
 Casing Schedule None
 (Amount, Size, Setting—New, Used—Steel, Galv.—Gage or Weight)

Screen Data (if any): _____
 (Length, Diameter, Slot Size, Setting)

Measured depth to water on completed well (Static Level) is _____ ft. below _____
 (Land Surface, Top of Casing, Etc.)

TESTED YIELD: _____ gallons per _____ (Min., Hour)
 as determined by _____ (Bailing, Test Pumping, Etc.)

DRAWDOWN: _____ ft. after _____ hrs.
 pumping at _____ gal. per minute.

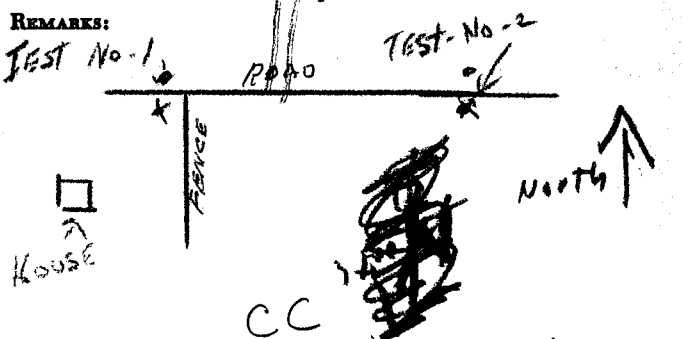

LOCATION OF WELL Topographic Sheet Basehor
 [Show location in Section Plat] Elev. _____

SW 1/4 SW 1/4 Sec. 28
 T. 10 S., R. 22 E.
 County Revere, Mo
 #1 BR=907
 #2 BR=880

"To preserve water well information and to promote the conservation, protection, and development of ground-water resources."

KANSAS WELL SCHEDULE

Card 1

Record by Kleinschmitt Date: 4-12-73 Project: Top-RC State: Kan County: Leav 52

Latitude: _____ Longitude: _____ Accuracy: _____ Owner's well no: _____

Location: SW SW no. sec. 28, T. 10 N., R. 22 E. Well number: 1022E28CC

Owner: Bascher Water Dist #4 name address Bascher R

Owner: WATER DIST NO. 4 Altitude: _____ Accuracy _____

Driller: Brewer name address _____ Date drilled: _____

Topography, well site: (D) Draw, (F) flood plain, (L) lowland, (R) rolling, (S) slope, (T) terrace, (U) U Spring; or depth of well: 75 100 75 R 3

Diameter: _____ inches or feet _____ Depth cased: _____ feet _____ Spring, or Csg. type: _____ Finish: _____ Lift & power: _____

Pump setting: _____ feet _____ Use of well: Domestic, stock, irrigation, industrial, public supply, observation, none, test _____

Water level: sealed above lsd _____ below _____ Water level records avail. _____

Description MP: sealed @ city & Rural supply wells above lsd _____ below _____

Yield: 10 15 15 R 3 Pumping period: _____ hours or days _____ Specific capacity: _____ gpm/ft. dd _____

Pumpage and other data available: _____

Card 2

Coefficient trans: _____ gpd/ft _____ Coefficient storage: _____ Coefficient perm.: _____ gpd/ft².

Aquifer, system or series _____

Aquifer, units _____

Aquifer, thickness: _____ feet _____ Aquifer, length of well open to: _____ feet _____ Aquifer, depth to top of: _____ lsd _____ feet _____ Aquifer, origin: _____

Aquifer, lithology of: _____

Bedrock, system: _____ Bedrock, formation: _____ Bedrock, depth to: _____ lsd _____ feet _____

Surficial material: _____ lithology _____ infiltration characteristics _____ Log data avail: Drillers log _____

Quality of water data available: _____ Temperature of water: _____ °F. _____ Date sampled: _____

Coefficient of leakage _____

THE FOLLOWING DATA ARE USED ON THE NATIONAL WELL SCHEDULE Ownership category: (C) County, (F) Federal Gov't., (M) M City, (N) Corp. or Co., (P) Private, (S) State Agency, (W) W Water Dist. _____

Method drilled: (A) Air, (B) bored, (C) cable, (D) dug, (V) driven, (H) H hyd. rotary, (J) jetted, (R) rev. rotary, (T) trenching, (S) spring, _____

Physiographic province: _____ Section: _____

Drainage basin: _____ Subbasin: _____ Depth to basement: _____ source of data (basement) _____

Quadrangle _____ Well no. _____

