


1 LOCATION OF WATER WELL: Fraction NW 1/4 NE 1/4 SW 1/4 Section Number 20 Township Number T 10 S Range Number R 22 EW
 County: Leavenworth

Distance and direction from nearest town or city street address of well if located within city? 2.5 miles NW of Bascher, Ks

2 WATER WELL OWNER: Clint Keller
 RR#, St. Address, Box #: 21610 179th Board of Agriculture, Division of Water Resources
 City, State, ZIP Code: Topeka, Ks 666086 Application Number:

3 LOCATE WELL'S LOCATION WITH AN "X" IN SECTION BOX: 4 DEPTH OF COMPLETED WELL 130 ft. ELEVATION: _____

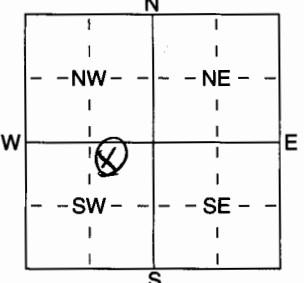

Depth(s) Groundwater Encountered 1 35 ft. 2 96 ft. 3 _____ ft.
 WELL'S STATIC WATER LEVEL _____ ft. below land surface measured on mo/day/yr _____
 Pump test data: Well water was _____ ft. after _____ hours pumping _____ gpm
 Est. Yield 25 gpm: Well water was _____ ft. after _____ hours pumping _____ gpm
 WELL WATER TO BE USED AS: 5 Public water supply 8 Air conditioning 11 Injection well
1 Domestic 3 Feedlot 6 Oil field water supply 9 Dewatering 12 Other (Specify below)
 2 Irrigation 4 Industrial 7 Domestic (lawn & garden) 10 Monitoring well

Was a chemical/bacteriological sample submitted to Department? Yes _____ No ; If yes, mo/day/yr sample was submitted
 Water Well Disinfected? Yes No

5 TYPE OF BLANK CASING USED: 5 Wrought iron 8 Concrete tile CASING JOINTS: Glued _____ Clamped _____
 1 Steel 3 RMP (SR) 6 Asbestos-Cement 9 Other (specify below) Welded _____
2 PVC 4 ABS 7 Fiberglass _____ Threaded _____

Blank casing diameter _____ in. to 30 ft., Dia 5 in. to 90 ft., Dia 5 in. to 110 ft.
 Casing height above land surface 18 in., weight 220 PSI lbs./ft. Wall thickness or guage No. SDR21

TYPE OF SCREEN OR PERFORATION MATERIAL: 7 PVC 10 Asbestos-Cement
 1 Steel 3 Stainless Steel 5 Fiberglass 8 RMP (SR) 11 Other (Specify) _____
 2 Brass 4 Galvanized Steel 6 Concrete tile 9 ABS 12 None used (open hole)

SCREEN OR PERFORATION OPENINGS ARE: 5 Gauzed wrapped 8 Saw cut 11 None (open hole)
 1 Continuous slot 3 Mill slot 6 Wire wrapped 9 Drilled holes
 2 Louvered shutter 4 Key punched 7 Torch cut 10 Other (specify) _____ ft.

SCREEN-PERFORATED INTERVALS: From 30 ft. to 50 ft., From 90 ft. to 110 ft.
 From _____ ft. to _____ ft., From _____ ft. to _____ ft.
 GRAVEL PACK INTERVALS: From 20 ft. to 130 ft., From _____ ft. to _____ ft.
 From _____ ft. to _____ ft., From _____ ft. to _____ ft.

6 GROUT MATERIAL: 1 Neat cement 2 Cement grout 3 Bentonite 4 Other _____
 Grout Intervals: From 0 ft. to 20 ft., From _____ ft. to _____ ft., From _____ ft. to _____ ft.

What is the nearest source of possible contamination: 1 Septic tank 10 Livestock pens 14 Abandoned water well
 2 Sewer lines 4 Lateral lines 7 Pit privy 11 Fuel storage 15 Oil well/Gas well
 3 Watertight sewer lines 5 Cess pool 8 Sewage lagoon 12 Fertilizer storage 16 Other (specify below)
 6 Seepage pit 9 Feedyard 13 Insecticide storage

Direction from well? West How many feet? +200'

FROM	TO	LITHOLOGIC LOG	FROM	TO	PLUGGING INTERVALS
<u>0</u>	<u>7</u>	<u>Clay</u>			
<u>7</u>	<u>15</u>	<u>Steady clay</u>			
<u>15</u>	<u>112</u>	<u>Sandstone</u>			
<u>112</u>	<u>115</u>	<u>Limestone</u>			

7 CONTRACTOR'S OR LANDOWNER'S CERTIFICATION: This water well was (1) constructed, (2) reconstructed, or (3) plugged under my jurisdiction and was completed on (mo/day/year) 10/5/06 and this record is true to the best of my knowledge and belief. Kansas Water Well Contractor's Licence No 595. This Water Well Record was completed on (mo/day/yr) 10/4/06 under the business name of Jesse Yeakum Well Drilling by (signature) Jesse Yeakum