

WATER WELL RECORD

not entered

DRILLERS LOG OF WELL


FROM (FT.)	TO (FT.)	KIND OF MATERIAL, COLOR, ETC. (NOTE WATER ZONES, AMOUNT, QUALITY)
0	2	Top soil
2	25	Clay yellow
25	27	Sand water
27	51	Clay yellow
51	81	Shale
81	85	Lime
85	87	Shale
87	100	Lime T.D.

Well Owner Martin Murrin
 Address 1 mile west of Piper, Kan.
 Drilling Contractor Breuer Drilling Co.
 Date Drilled December 1955
 Method of Drilling Cable Tool
Used 8 in. steel
 Casing: (New, Used—Steel; Galv.—Gage or Weight)
 Casing Schedule: 80' slotted
 (Amount, Size, Setting)
Graveled packed
 Screen Data (if any): none

ON COMPLETED WELL

Measured depth to water (Static Level) is 40 ft. below land surface
 (Land Surface, Top of Casing, Etc.)
 TESTED YIELD: _____ gallons per _____ (Min., Hour)
 as determined by _____ (Bailing, Test Pumping, Etc.)
 DRAWDOWN: _____ ft. after _____ hrs.
 pumping at _____ gal. per minute.

REMARKS: 60ft. of water over night.
1/2 Submersible pump installed.
8" Hole

 

LOCATION OF WELL
 [Show location in Section Plat] Basin 74c
 Elev. 975±
 _____ § NW § Sec. 3E
 T. 10 S., R. 23 W.
 County Wyand

"To preserve water well information and to promote the conservation, protection, and development of ground-water resources."