

USE TYPEWRITER OR BALL POINT PEN-PRESS FIRMLY, PRINT CLEARLY.


WATER WELL RECORD
KSA 32a-1201-1215

Kansas Department of Health and Environment-Division of Environment (Water well Contractors) Topeka, Kansas 66620

checked 1-13-81

1. Location of well: County Leavenworth Fraction NW NE 1/4 NE 1/4 Section number 33 Township number T 10 S R 23 Range number (E)W

2. Distance and direction from nearest town or city: 1/2 mile east of Piper, Kansas
Street address of well location if in city: _____
3. Owner of well: Ray Dillon (Builder)
R.R. or street: _____
City, state, zip code: _____

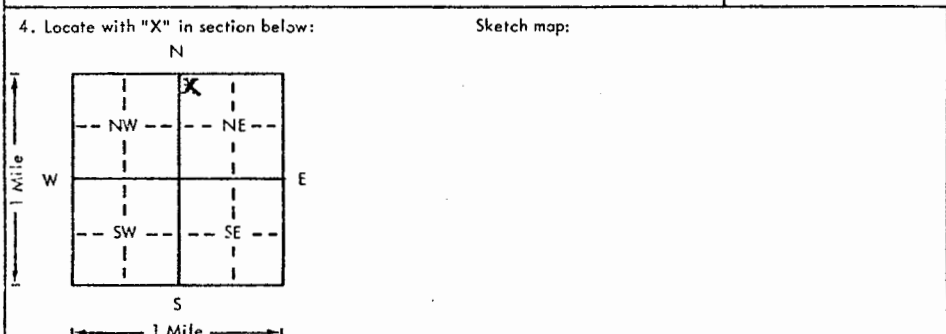

6. Bore hole dia. 8 in. Completion date 8-28-78
Well depth 120 ft.
7. Cable tool Rotary Driven Dug
 Hollow rod Jetted Bored Reverse rotary
8. Use: Domestic Public supply Industry
 Irrigation Air conditioning Stock
 Lawn Oil field water Other
9. Casing: Material PL Height: Above or below
Threaded Welded Surface 18 in.
RMP PVC Weight _____ lbs./ft.
Dia. 5 in. to 121 ft. depth Wall Thickness: inches or
Dia. _____ in. to _____ ft. depth gage No. .265

5. Type and color of material	From	To
Top Soil	0	1
Sandy Clay	1	6
Sandstone	6	13
Sandy Lime	13	15
Sandy Shale	15	17
Lime	17	22
Shale	22	29
Lime	29	41
Shale	41	47
Lime	47	52
Shale	52	70
X Lime	70	88
Shale	88	113
Lime	113	120
(Use a second sheet if needed)		

10. Screen: Manufacturer's name (Slotted Pipe) Vinylplex, Inc.
Type PVC Dia. 5"
Slot/gauze .06 1/16 Length 20' & 40'
Set between 13 ft. and 33 ft.
80 ft. and 120 ft.
Gravel pack? Size range of material 1/4 - 1/8
11. Static water level: 15 ft. below land surface Date 8-28-78 mo./day/yr.
12. Pumping level below land surfaces:
_____ ft. after _____ hrs. pumping _____ g.p.m.
_____ ft. after _____ hrs. pumping _____ g.p.m.
Estimated maximum yield 20 g.p.m.
13. Water sample submitted: _____ mo./day/yr.
Yes No Date _____
14. Well head completion: Pitless adapter 18 inches above grade
15. Well grouted? Yes
With: Neat cement Bentonite Concrete
Depth: From 3 ft. to 13 ft.
16. Nearest source of possible contamination:
ft. 200' Direction SE Type Septic
Well disinfected upon completion? Yes No
17. Pump: Not installed
Manufacturer's name _____ HP _____ Volts _____
Model number _____
Length of drop pipe _____ ft. capacity _____ g.p.m.
Type:
 Submersible Turbine
 Jet Reciprocating
 Centrifugal Other

18. Elevation: 760
Topography: M-E
 Hill
 Slope
 Upland
 Valley

19. Remarks: 930 from map RM

20. Water well contractor's certification:
This well was drilled under my jurisdiction and this report is true to the best of my knowledge and belief.
BREUER, INC. 174
Business name _____ License No. _____
Address Box 147, Basehor, Ks.
Signed [Signature] Date 9-1-78