

CORRECTION(S) TO WATER WELL RECORD (WWC-5)

(to rectify lacking or incorrect information)

County: Wyandotte

Location listed as:

Section-Township-Range: 35-10 S-23 E

Fraction (1/4 1/4 1/4): None Given

Location changed to:

35-10 S-23 E

NW NW NW

Other changes: Initial statements: _____

Changed to: _____

Comments: _____


verification method: written & legal descriptions, and mapping tool
on KGS website, & satellite images on Google
website. initials: ORL date: 10/4/2006

submitted by: Kansas Geological Survey, Data Resources Library, 1930 Constant Ave., Lawrence, KS 66047-3726
to: Kansas Dept of Health & Environment, Bureau of Water, 1000 SW Jackson, Suite 420, Topeka, KS 66612-1367.

1 LOCATION OF WATER WELL: County: Wyandotte	Fraction $\frac{1}{4}$ $\frac{1}{4}$ $\frac{1}{4}$	Section Number 35	Township Number 10 S	Range Number 23 (E)
---	---	-----------------------------	--------------------------------	---

Distance and direction from nearest town or city street address of well if located within city?
1 mile W of K.C N. 310399.435 E. 2212633.934

2	WATER WELL OWNER: Emery Sepp & Sons, Inc. RR #, St. Address, Box #: 600 Broadway Suite 260 City, State, ZIP Code: Kansas City, MO 64105	Board of Agriculture, Division of Water Resources Application Number:
---	--	--

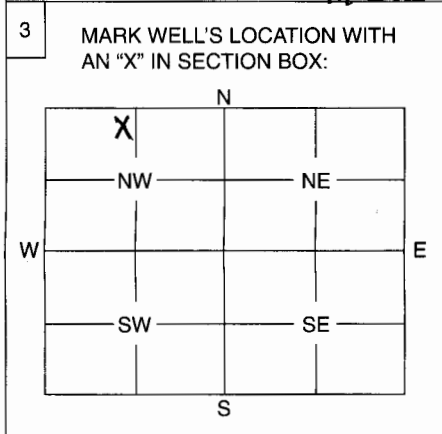

4 DEPTH OF WELL **60** ft. **Note! Not sure "X" on map is correct**

WELL'S STATIC WATER LEVEL **17** ft.

WELL WAS USED AS: **Old farm well**

<input checked="" type="checkbox"/> 1 Domestic	5 Public Water Supply	9 Dewatering
<input checked="" type="checkbox"/> 2 Irrigation	6 Oil Field Water Supply	10 Monitoring Well
<input type="checkbox"/> 3 Feedlot	7 Domestic (Lawn & Garden)	11 Injection Well
<input type="checkbox"/> 4 Industrial	8 Air Conditioning	12 Other

Was a chemical / bacteriological sample submitted to Department? Yes No

If yes, mo/day/yr sample was submitted

Water Well Disinfected: Yes No

5 TYPE OF BLANK CASING USED:

1 Steel	3 RMP (SR)	5 Wrought	7 Fiberglass	9 Other (Specify below)
2 PVC	4 ABS	6 Asbestos-Cement	8 Concrete Tile	None

No casing Approx 10" Dia.

Blank casing diameter in. Was casing pulled? Yes No If yes, how much

Casing height above or below land surface in.

6 GROUT PLUG MATERIAL: 1 Neat cement 2 Cement grout 3 Bentonite 4 Other

Grout Plug Intervals: From **60** ft. to **0** ft., From ft. to ft., From to ft.

What is the nearest source of possible contamination:

1 Septic tank	6 Seepage pit	11 Fuel storage	16 Other (specify below)
2 Sewer lines	7 Pit privy	12 Fertilizer storage	Unknown
3 Watertight sewer lines	8 Sewage lagoon	13 Insecticide storage	
4 Lateral lines	9 Feedyard	14 Abandoned water well	
5 Cess pool	10 Livestock pens	15 Oil well/Gas well	

Direction from well? How many feet?

FROM	TO	PLUGGING MATERIALS
60	0	Cement grout

Water Well is located in housing development being constructed.

7 CONTRACTOR'S OF LANDOWNER'S CERTIFICATION: This water well was plugged under my jurisdiction and was completed on (mo/day/year) **8/2/06** **8/16/06** and this record is true to the best of my knowledge and belief. Kansas Water Well Contractor's License No. **591** This Water Well Record was completed on (mo/day/year) **8/2/06** under the business name of **K-W Oil Well Service Inc.**

by (signature) *[Signature]*

INSTRUCTIONS: Use typewriter or ball point pen. Please press firmly and print clearly. Please fill in blanks, underline or circle the correct answers. Send top three copies to Kansas Department of Health and Environment, Bureau of Water, Geology Section, 1000 SW Jackson St., Ste. 420, Topeka, Kansas 66612-1367. Telephone: 785/296-5522. Send one to Water Well Owner and retain one for your records.