

WATER WELL PLUGGING RECORD Form WWC-5P KSA 82a-1212 ID NO.

MW4

1 LOCATION OF WATER WELL: County: Wyandotte	Fraction	Section Number	Township Number	Range Number
	SE¼ SW¼ SW¼ SE¼	35	T 10 S	23 <input checked="" type="checkbox"/> E <input type="checkbox"/> W


Street/Rural Address of Well Location: if unknown, distance & direction from nearest town or intersection: If at owner's address, check here
10950 Parallel Parkway, Kansas City, KS

Global Positioning Systems (GPS) information:
Latitude: 39.12907 (in decimal degrees)
Longitude: 94.83480 (in decimal degrees)
Elevation: _____

Horizontal Datum WGS84, NAD83, NAVD27
Collection Method:

2 WATER WELL OWNER: Star Fuel Centers, Inc.
RR#, St. Address, Box #: 7415 W 130th St., Suite 100
City, State ZIP Code: Overland Park, KS 66213

GPS unit (Make/model: _____)
 Digital Map/Photo, Topographic Map Land Survey
Est. Accuracy: <3 m, 3-5 m, 5-15 m, >15 m

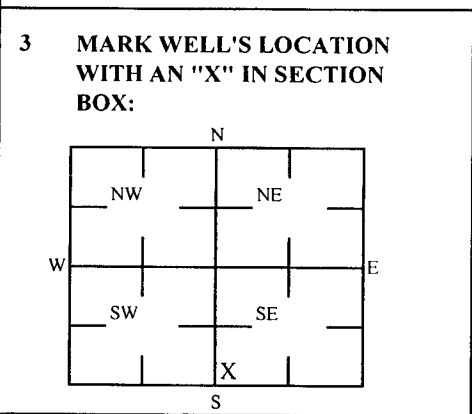

4 DEPTH OF WELL 18.9 ft. MW4
WELL'S STATIC WATER LEVEL _____ ft
WELL WAS USED AS:
 Domestic Public Water Supply Dewatering
 Irrigation Oil Field Water Supply Monitoring
 Feedlot Domestic (Lawn & Garden) Injection Well
 Industrial Air Conditioning Other _____
Was a chemical/bacteriological sample submitted to Department? Yes No

5 TYPE OF BLANK CASING USED:
 Steel RMP (SR) Wrought Fiberglass Other (Specific below)
 PVC ABS Asbestos-Cement Concrete Tile _____
Blank casing diameter 2 in. Was casing pulled? Yes No If yes, how much 3 ft
Casing high above or below land surface NA in.

6 GROUT PLUG MATERIAL: Neat cement Cement grout Bentonite Other Concrete: 0-0.5'
Grout Plug Intervals: From 0.5 ft to 18.9 ft, From _____ ft to _____ ft, From _____ ft to _____ ft,
What is the nearest source of possible contamination:
 Septic tank Seepage pit Fuel storage Other (specify below) _____
 Sewer lines Pit privy Fertilizer storage _____
 Watertight sewer lines Sewage lagoon Insecticide storage _____
 Lateral lines Feed yard Abandoned water well Direction from well? _____
 Cess pool Livestock pens Oil well/Gas well How many feet? _____

FROM	TO	PLUGGING MATERIALS	FROM	TO	PLUGGING MATERIALS
0	0.5	Concrete			
0.5	18.9	Bentonite			

KDHE ID: 7-11Star Fuel #707; U4-105-15169

7 CONTRACTOR'S OR LANDOWNER'S CERTIFICATION: This water well was plugged under my jurisdiction and was completed on (mo/day/year) 6/22/22 and this record is true to the best of my knowledge and belief. Kansas Water Contractor's License No. 757. This Water Well Record was completed on (mo/day/year) 6/24/22 under the business name of Larsen & Associates, Inc. By (signature) _____

Send one white copy to Kansas Department of Health & Environment, Geology Section, 1090 SW Jackson Street, Rm. 420, Topeka, KS 66612-1367. Send one copy to WATER WELL OWNER and retain one for your records
Visit us at <http://www.kdheks.gov/waterwell/index.html> Telephone 785-296-5524.

NOTE: Figures exhibited within this report are only to be used within the context of this report. Placement of property lines, wells, structures, and roads is based on the available information from county appraiser maps, surveys, site visits, and/or previous vendor reports and should be considered approximate.

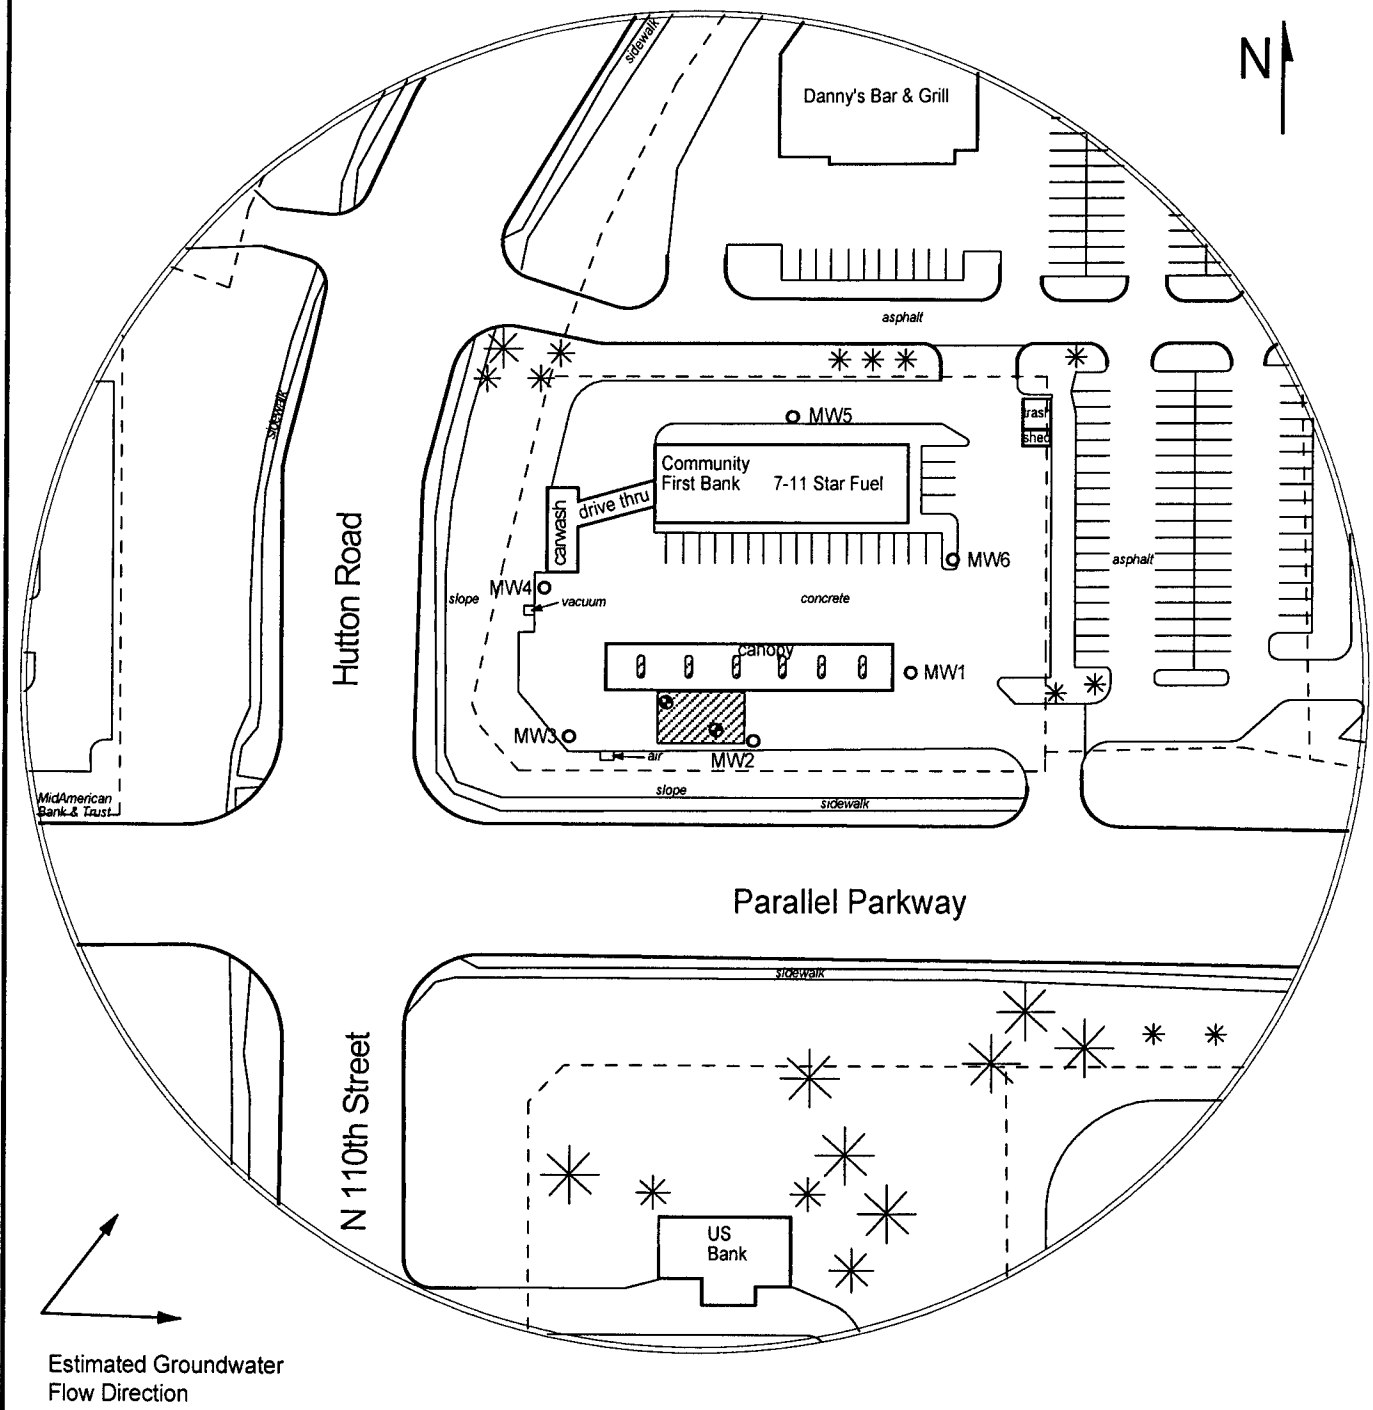


FIGURE 1 - 350 FT RADIUS AREA BASE MAP



PROJECT:
 7-11 Star Fuel #707
 10950 Parallel Parkway
 Kansas City, KS
 KDHE ID: U4-105-15169
 Date: 6/22/22

LEGEND:

- Approximate Location of Active UST Basin & Pump Islands
- Approximate Location of Property Line
- Observation Well
- Plugged Monitoring Well

1311 E 25th St. Suite B 785-841-8707 office
 Lawrence, KS 66046 785-865-4282 fax



NOTE: Location of active product lines is unknown.