


USE TYPEWRITER OR BALL POINT PEN—PRESS FIRMLY, PRINT CLEARLY.

WATER WELL RECORD
KSA 82a-1201-1215

Kansas Department of Health and Environment—Division of Environment (Water well Contractors)
Topeka, Kansas 66620

1. Location of well: County Wyandotte Fraction SW_{1/4} SW_{1/4} SW_{1/4} Section number 5 Township number T 10 S R 23 Range number 10-18-78 E/W

2. Distance and direction from nearest town or city: 3 miles south of Leavenworth, Ks. 3. Owner of well: Tom Lewis
R.R. or street: ?? City, state, zip code: _____

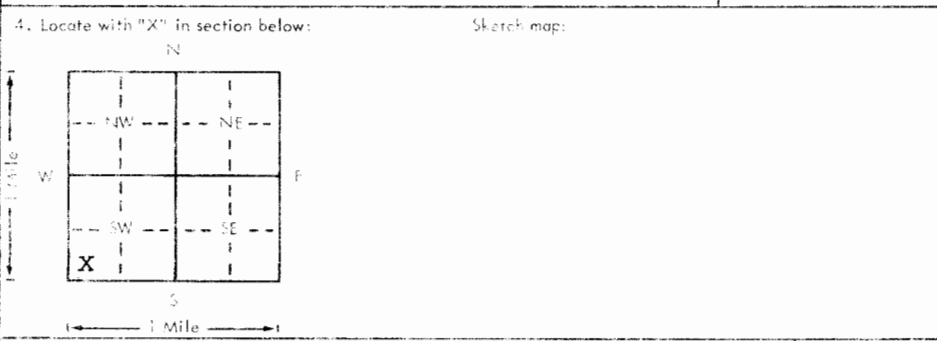

6. Bore hole dia. 8 in. Completion date 10-18-78
Well depth 125 ft.

7. Cable tool Rotary Driven Dug
 Hollow rod Jetted Bored Reverse rotary

8. Use: Domestic Public supply Industry
 Irrigation Air conditioning Stock
 Lawn Oil field water Other

9. Casing: Material: PL Height: Above or Below
Threaded Welded Surface 18 in.
RMP PVC Weight _____ lbs./ft.
Dia. 5 in. to 127 ft. depth Wall thickness: inches or
Dia. _____ in. to _____ ft. depth Gage No. 265

3. Type and color of material	From	To
Top Soil	0	1
Clay	1	7
Sandstone - Yellow	7	20
Sandy Shale	20	60
Sandstone - Yellow	60	95
Sandstone - Gray	95	122
Lime	122	125
(Use a second sheet if needed)		

10. Screens: Manufacturer's name (Slotted Pipe Vinylplex, Inc.)
Type PVC Dia. 5"
Slot/gauze .06 1/16 Length 22'
Set between 100 ft. and 122 ft.
_____ ft. and _____ ft.

11. Static water level: _____ mg./day/yr.
80 ft. below land surface Date 10-18-78

12. Pumping level below land surfaces:
_____ ft. after _____ hrs. pumping _____ g.p.m.
_____ ft. after _____ hrs. pumping _____ g.p.m.
Estimated maximum yield 20 g.p.m.

13. Water sample submitted: _____ mg./day/yr.
Yes No Date _____

14. Well head completion:
 Pitless adapter 18 inches above grade

15. Well grouted? Yes
With Neat cement Bentonite Concrete
Depth: from 3 ft. to 15 ft.

16. Nearest source of possible contamination:
ft. 100 Direction east Type septic
Well disinfected upon completion? Yes No

17. Pumps: _____ Not installed
Manufacturer's name Jacuzzi
Model number 5S4B HP 1/2 Volts 220
Length of drop pipe 115 ft. capacity 10 g.p.m.
Type:
 Submersible Turbine
 Jet Reciprocating
 Centrifugal Other

18. Elevation: 6
Topography: _____
_____ Hill
_____ Slope
_____ Upland
_____ Valley

19. Remarks:

20. Water well contractor's certification:
This well was drilled under my jurisdiction and this report is true to the best of my knowledge and belief.
BREUER, INC. 174
Business name License No.
Address: Box 147, Basehor, Ks.
Signed: [Signature] Date 10-19-78