


1 LOCATION OF WATER WELL: Fraction SW 1/4 NE 1/4 SW 1/4 Section Number 20 Township Number T 10 S Range Number R 23 EW
 County: WYANDOTTE

Distance and direction from nearest town or city street address of well if located within city?
3 MILES NE. OF BASEHOR KANSAS

2 WATER WELL OWNER: ROBERT W. HARTMAN
 RR#, St. Address, Box #: 1925 121ST STREET Board of Agriculture, Division of Water Resources
 City, State, ZIP Code: KANSAS CITY, KS 66109 Application Number:

3 LOCATE WELL'S LOCATION WITH AN "X" IN SECTION BOX: 4 DEPTH OF COMPLETED WELL: 100 ft. ELEVATION: 940'

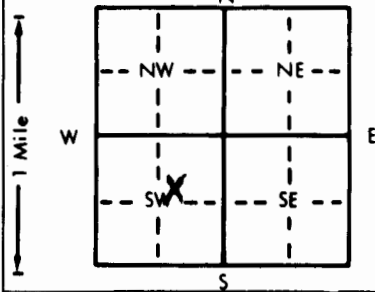

Depth(s) Groundwater Encountered 1. ft. 2. ft. 3. ft.
 WELL'S STATIC WATER LEVEL 34 ft. below land surface measured on mo/day/yr 11/23/87
 Pump test data: Well water was ft. after hours pumping gpm
 Est. Yield 48 gpm: Well water was ft. after hours pumping gpm
 Bore Hole Diameter 8 1/2 in. to 100 ft., and in. to ft.
 WELL WATER TO BE USED AS:
 1 Domestic 3 Feedlot 6 Oil field water supply 9 Dewatering 12 Other (Specify below)
 2 Irrigation 4 Industrial 7 Lawn and garden only 10 Observation well
 Was a chemical/bacteriological sample submitted to Department? Yes No X; If yes, mo/day/yr sample was submitted
 Water Well Disinfected? Yes No

5 TYPE OF BLANK CASING USED:
 1 Steel 3 RMP (SR) 5 Wrought iron 8 Concrete tile CASING JOINTS Glued Clamped
 2 PVC 4 ABS 6 Asbestos-Cement 9 Other (specify below) Welded
 7 Fiberglass Threaded

Blank casing diameter 5 in. to 35 ft., Dia 5 in. to 100 ft., Dia in. to ft.
 Casing height above land surface 18 in., weight 1.5 lbs./ft. Wall thickness or gauge No. 200

TYPE OF SCREEN OR PERFORATION MATERIAL:
 1 Steel 3 Stainless steel 5 Fiberglass 7 PVC 10 Asbestos-cement
 2 Brass 4 Galvanized steel 6 Concrete tile 9 ABS 11 Other (specify)
 12 None used (open hole)

SCREEN OR PERFORATION OPENINGS ARE:
 1 Continuous slot 3 Mill slot 5 Gauzed wrapped 8 Saw cut 11 None (open hole)
 2 Louvered shutter 4 Key punched 6 Wire wrapped 9 Drilled holes
 7 Torch cut 10 Other (specify)

SCREEN-PERFORATED INTERVALS: From 40 ft. to 35 ft., From ft. to ft.
 From ft. to ft., From ft. to ft.
 GRAVEL PACK INTERVALS: From 100 ft. to 25 ft., From ft. to ft.
 From ft. to ft., From ft. to ft.

6 GROUT MATERIAL: 1 Neat cement 2 Cement grout 3 Bentonite 4 Other
 Grout Intervals: From 25 ft. to 3 ft., From ft. to ft., From ft. to ft.

What is the nearest source of possible contamination:
 1 Septic tank 4 Lateral lines 7 Pit privy 10 Livestock pens 14 Abandoned water well
 2 Sewer lines 5 Cess pool 8 Sewage lagoon 11 Fuel storage 15 Oil well/Gas well
 3 Watertight sewer lines 6 Seepage pit 9 Feedyard 12 Fertilizer storage 16 Other (specify below)
 13 Insecticide storage

Direction from well? How many feet? 150'

FROM	TO	LITHOLOGIC LOG	FROM	TO	LITHOLOGIC LOG
0	1	SURFACE			
1	22	CLAY (SANDY)			
22	24	GRAY MUD (VERY SANDY)			
24	42	SAND WITH PEA GRAVEL			
42	55	SHALE			
55	56	LIME			
56	63	SHALE			
63	67	LIME			
67	71	SHALE			
71	76	LIME			
76	95	SHALE			
95	100	LIME			

7 CONTRACTOR'S OR LANDOWNER'S CERTIFICATION: This water well was (1) constructed, (2) reconstructed, or (3) plugged under my jurisdiction and was completed on (mo/day/year) 11/3/87 and this record is true to the best of my knowledge and belief. Kansas Water Well Contractor's License No. 240 This Water Well Record was completed on (mo/day/yr) 11/4/87 under the business name of F.E. YOUNG DRILLING CO. by (signature) F. E. Young