5

R

USE TYPEWRITER OR BALL POINT PEN-PRESS FIRMLY, PRINT CLEARLY.

WATER WELL RECORD
KSA 82a-1201-1215

Kansas Department of Health and Environment-Division of Environment
(Water well Contractors)
Topeka, Kansas 66620

1. Location of well:	County: Wyandotte	Fraction: NW 1/4 NW 1/4 NE 1/4	Section number: 21	Township number: T 10 S	Range number: R 23 (E/W)

2. Distance and direction from nearest town or city: 2 miles north of Piper, Kansas
Street address of well location if in city:

3. Owner of well: Mr. Wm. Knetter
R.R. or street: 11801 Hollingsworth Road
City, state, zip code: Kansas City, Kansas

4. Locate with "X" in section below:

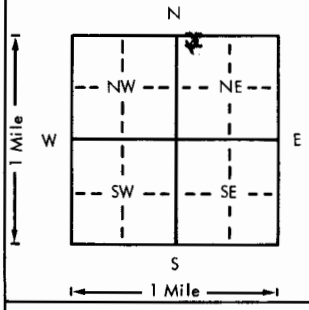

Sketch map:

6. Bore hole dia. 8 in. Completion date 6-26-77
Well depth 80 ft.

7. __ Cable tool X Rotary __ Driven __ Dug
__ Hollow rod __ Jetted __ Bored __ Reverse rotary

8. Use: X Domestic __ Public supply __ Industry
__ Irrigation __ Air conditioning __ Stock
__ Lawn __ Oil field water __ Other

9. Casing: Material PL. Height: Above or below
Threaded ___ Welded X Surface ___ 18 in.
RMP ___ PVC X Weight ___ lbs./ft.
Dia. 5 in. to 82 ft. depth Wall Thickness: inches or
Dia. ___ in. to ___ ft. depth gage No. .265

5. Type and color of material	From	To
Top Soil	0	3
Clay	3	20
Sandy Clay	20	56
Blue Mud	56	60
Sand & Silt	60	62
Lime	62	74
Shale	74	78
Lime	78	80
(Use a second sheet if needed)		

10. Screen: Manufacturer's name (Slotted Pipe) Vinylplex, Inc.
Type PVC Dia. 5"
Slot/gauze .06 1/16 Length 40'
Set between 40 ft. and 80 ft.
___ ft. and ___ ft.
Gravel pack? X Size range of material 1/4 - 1/8

11. Static water level: mo./day/yr.
30 ft. below land surface Date 6-26-77

12. Pumping level below land surfaces:
___ ft. after ___ hrs. pumping ___ g.p.m.
___ ft. after ___ hrs. pumping ___ g.p.m.
Estimated maximum yield 10 g.p.m.

13. Water sample submitted: mo./day/yr.
__ Yes X No Date

14. Well head completion:
X Pitless adapter 18 Inches above grade

15. Well grouted? Yes
With: X Neat cement ___ Bentonite ___ Concrete
Depth: From 3 ft. to 15 ft.

16. Nearest source of possible contamination:
ft. 300' Direction west Type barn
Well disinfected upon completion? X Yes ___ No

17. Pump: ___ Not installed
Manufacturer's name Jacuzzi
Model number 5S4B HP 1/2 Volts 220
Length of drop pipe 75 ft. capacity 10 g.p.m.
Type:
X Submersible ___ Turbine
___ Jet ___ Reciprocating
___ Centrifugal ___ Other

T 10 R 23 W (E) Sec 21 1/4 NW NW NE 1/4

18. Elevation:
Topography:
___ Hill
___ Slope
___ Upland
___ Valley

19. Remarks:
9/1

20. Water well contractor's certification:
This well was drilled under my jurisdiction and this report is true to the best of my knowledge and belief.
BREUER, INC. License No. 174
Business name
Address Box 147, Basehor, Ks. 66007
Signed [signature] Authorized representative Date 7-5-77

Forward the white, blue and pink copies to the Department of Health and Environment

Form WWC-5

BR = 88$6

∇ = 91$

MI-1023