


1 LOCATION OF WATER WELL: County: **WYANDOTTE** Fraction: $\frac{1}{4}$ $\frac{1}{4}$ SE $\frac{1}{4}$ Section Number: **34** Township Number: T **10** S Range Number: R **23** ~~25~~ E **10**

Distance and direction from nearest town or city street address of well if located within city?
2029 FAIRFAX TRAFFICWAY WELL No. **11**

2 WATER WELL OWNER: **PHILLIPS PETROLEUM COMPANY**
 RR#, St. Address, Box #: **2029 FAIRFAX TRAFFICWAY**
 City, State, ZIP Code: **KANSAS CITY, KS 66115**
 Board of Agriculture, Division of Water Resources
 Application Number:

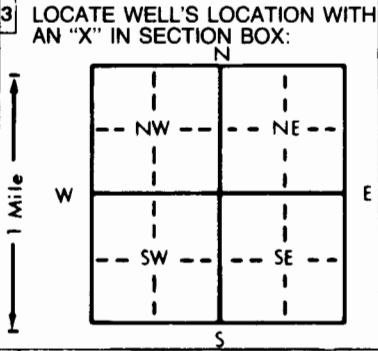

4 DEPTH OF COMPLETED WELL: **76** ft. ELEVATION: **T.O.C. @ 749.60' MSL**
 Depth(s) Groundwater Encountered 1. ft. 2. ft. 3. ft.
 WELL'S STATIC WATER LEVEL: **25** ft. below land surface measured on mo/day/yr
 Pump test data: Well water was ft. after hours pumping gpm
 Est. Yield gpm: Well water was ft. after hours pumping gpm
 Bore Hole Diameter: **28** in. to **76** ft., and in. to ft.
 WELL WATER TO BE USED AS:
 1 Domestic 3 Feedlot 6 Oil field water supply 9 Dewatering **12 Other (Specify below)**
 2 Irrigation 4 Industrial 7 Lawn and garden only 10 Monitoring well **PETRO RECOVERY WELL**
 Was a chemical/bacteriological sample submitted to Department? Yes.....No **X**.....; If yes, mo/day/yr sample was submitted
 Water Well Disinfected? Yes **(NO)**

5 TYPE OF BLANK CASING USED:
 Steel 3 RMP (SR) 5 Wrought iron 8 Concrete tile CASING JOINTS: Glued Clamped
 PVC 4 ABS 6 Asbestos-Cement 9 Other (specify below) Welded
 Fiberglass Threaded
 Blank casing diameter: **12** in. to **25** ft., Dia in. to ft., Dia in. to ft.
 Casing height above land surface: **36** in., weight **49.56** lbs./ft. Wall thickness or gauge No. **STD**
 TYPE OF SCREEN OR PERFORATION MATERIAL:
 Steel Stainless steel 5 Fiberglass 8 RMP (SR) 10 Asbestos-cement
 Brass 4 Galvanized steel 6 Concrete tile 9 ABS 11 Other (specify)
 None used (open hole)
 SCREEN OR PERFORATION OPENINGS ARE:
 Continuous slot 3 Mill slot 5 Gauzed wrapped 8 Saw cut 11 None (open hole)
 Louvered shutter 4 Key punched Wire wrapped 9 Drilled holes
 Torch cut 10 Other (specify)
 SCREEN-PERFORATED INTERVALS: From **25** ft. to **76** ft., From ft. to ft.
 From ft. to ft., From ft. to ft.
 GRAVEL PACK INTERVALS: From **17** ft. to **76** ft., From ft. to ft.
 From ft. to ft., From ft. to ft.

6 GROUT MATERIAL: Neat cement Cement grout Bentonite Other
 Grout Intervals: From **0** ft. to **17** ft. From **15** ft. to **17** ft. From ft. to ft.
 What is the nearest source of possible contamination:
 Septic tank 4 Lateral lines 7 Pit privy Fuel storage 10 Livestock pens 14 Abandoned water well
 Sewer lines 5 Cess pool 8 Sewage lagoon 12 Fertilizer storage 15 Oil well/Gas well
 Watertight sewer lines 6 Seepage pit 9 Feedyard 13 Insecticide storage 16 Other (specify below)

Direction from well? How many feet?

FROM	TO	LITHOLOGIC LOG	FROM	TO	PLUGGING INTERVALS
0	11.5	GRAVEL FILL			
11.5	19.0	GR SI CLAY V. SOFT			
19.0	24.0	GR SA SILT			
24.0	34.0	GR FINE SAND			
34.0	39.0	GR MED. TO COARSE SAND			
39.0	67.0	GR MED TO FINE SAND			
67.0	69.0	GR MED TO COARSE SAND			
69.0	74.0	GR SI CLAY SOFT			
74.0	76.0	GR SI SAND			

7 CONTRACTOR'S OR LANDOWNER'S CERTIFICATION: This water well was constructed, (2) reconstructed, or (3) plugged under my jurisdiction and was completed on (mo/day/year) **9-3-92** and this record is true to the best of my knowledge and belief. Kansas Water Well Contractor's License No. **102 K** This Water Well Record was completed on (mo/day/yr) **9-23-92** under the business name of **LAYNE-DEGEN COMPANY** by (signature) *[Signature]*

INSTRUCTIONS: Use typewriter or ball point pen. PLEASE PRESS FIRMLY and PRINT clearly. Please fill in blanks, underline or circle the correct answers. Send top three copies to Kansas Department of Health and Environment, Bureau of Water, Topeka, Kansas 66620-0001. Telephone: 913-296-5545. Send one to WATER WELL OWNER and retain one for your records.