


1 LOCATION OF WATER WELL: Fraction $\frac{1}{4}$ $\frac{1}{4}$ **SE** $\frac{1}{4}$ Section Number **34** Township Number T **10** S Range Number R **23** E

Distance and direction from nearest town or city street address of well if located within city?
2029 FAIRFAX TRAFFICWAY, KC, KS WELL No. **10**

2 WATER WELL OWNER: **PHILLIPS PETROLEUM COMPANY**
 RR#, St. Address, Box #: **2029 FAIRFAX TRAFFICWAY** Board of Agriculture, Division of Water Resources
 City, State, ZIP Code: **KANSAS CITY, KS 66115** Application Number:

3 LOCATE WELL'S LOCATION WITH AN "X" IN SECTION BOX:

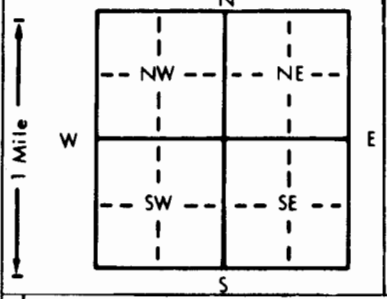

4 DEPTH OF COMPLETED WELL: **56** ft. ELEVATION: **T.O.C. @ 745.32' MSL**

Depth(s) Groundwater Encountered 1. ft. 2. ft. 3. ft.
 WELL'S STATIC WATER LEVEL ... **20** ... ft. below land surface measured on mo/day/yr **9-2-92**
 Pump test data: Well water was ft. after hours pumping gpm
 Est. Yield gpm: Well water was ft. after hours pumping gpm
 Bore Hole Diameter ... **28** ... in. to ... **56** ... ft., and ... in. to ... ft.
 WELL WATER TO BE USED AS: 5 Public water supply 8 Air conditioning 11 Injection well
 1 Domestic 3 Feedlot 6 Oil field water supply 9 Dewatering **② Other (Specify below)**
 2 Irrigation 4 Industrial 7 Lawn and garden only 10 Monitoring well **PETRO RECOVERY WELL**
 Was a chemical/bacteriological sample submitted to Department? Yes.....No...**X**...; If yes, mo/day/yr sample was submitted
 Water Well Disinfected? Yes **(No)**

5 TYPE OF BLANK CASING USED: 5 Wrought iron 8 Concrete tile CASING JOINTS: Glued Clamped
① Steel 3 RMP (SR) 6 Asbestos-Cement 9 Other (specify below) Welded
 2 PVC 4 ABS 7 Fiberglass Threaded

Blank casing diameter ... **12** ... in. to ... **13** ... ft., Dia ... in. to ... ft., Dia ... in. to ... ft.
 Casing height above land surface ... **36** ... in., weight ... **49.56** ... lbs./ft. Wall thickness or gauge No. **STD (40)**

TYPE OF SCREEN OR PERFORATION MATERIAL: 7 PVC 10 Asbestos-cement
 1 Steel **③ Stainless steel** 5 Fiberglass 8 RMP (SR) 11 Other (specify)

SCREEN OR PERFORATION OPENINGS ARE: 5 Gauzed wrapped 8 Saw cut 11 None (open hole)
 1 Continuous slot 3 Mill slot **⑥ Wire wrapped** 9 Drilled holes
 2 Louvered shutter 4 Key punched 7 Torch cut 10 Other (specify)

SCREEN-PERFORATED INTERVALS: From ... **15** ... ft. to ... **56** ... ft., From ... ft. to ... ft.
 From ... ft. to ... ft., From ... ft. to ... ft.
 GRAVEL PACK INTERVALS: From ... **7.8** ... ft. to ... **56** ... ft., From ... ft. to ... ft.
 From ... ft. to ... ft., From ... ft. to ... ft.

6 GROUT MATERIAL: 1 Neat cement **② Cement grout** **③ Bentonite** 4 Other
 Grout Intervals: From ... **0** ... ft. to ... **5.8** ... ft., From ... **5.8** ... ft. to ... **7.8** ... ft., From ... ft. to ... ft.

What is the nearest source of possible contamination:
 1 Septic tank 4 Lateral lines 7 Pit privy **① Fuel storage** 14 Abandoned water well
 2 Sewer lines 5 Cess pool 8 Sewage lagoon 12 Fertilizer storage 15 Oil well/Gas well
 3 Watertight sewer lines 6 Seepage pit 9 Feedyard 13 Insecticide storage 16 Other (specify below)

Direction from well? How many feet?

FROM	TO	LITHOLOGIC LOG	FROM	TO	PLUGGING INTERVALS
0	4.5	GRAVEL FILL			
4.5	24.0	GR. V. FINE SILTY SAND			
24.0	56.0	GR. MED TO COARSE SAND, SOME FINES			

7 CONTRACTOR'S OR LANDOWNER'S CERTIFICATION: This water well was **①** constructed, (2) reconstructed, or (3) plugged under my jurisdiction and was completed on (mo/day/year) **9-2-92** and this record is true to the best of my knowledge and belief. Kansas Water Well Contractor's License No. **102 K** This Water Well Record was completed on (mo/day/yr) **9-23-92** under the business name of **LAYNE-WESTERN COMPANY** by (signature) *[Signature]*

INSTRUCTIONS: Use typewriter or ball point pen. PLEASE PRESS FIRMLY and PRINT clearly. Please fill in blanks, underline or circle the correct answers. Send top three copies to Kansas Department of Health and Environment, Bureau of Water, Topeka, Kansas 66620-0001. Telephone: 913-296-5545. Send one to WATER WELL OWNER and retain one for your records.