

FINA 9477 Wyandotte Co.


M.W. #2

1 LOCATION OF WATER WELL: County: ~~LEAVENWORTH~~ Fraction: SW 1/4 SE 1/4 SW 1/4 Section Number: 36 Township Number: T 10 S Range Number: R 24 EW

Distance and direction from nearest town or city street address of well if located within city? 4812 PARALLEL PARKWAY KANSAS CITY, KS.

2 WATER WELL OWNER: FINA OIL & CHEMICAL RR#, St. Address, Box #: P.O. BOX 2126 City, State, ZIP Code: DALLAS, TEXAS 75211 Board of Agriculture, Division of Water Resources Application Number:

3 LOCATE WELL'S LOCATION WITH AN "X" IN SECTION BOX: 4 DEPTH OF COMPLETED WELL: 15' ft. ELEVATION:

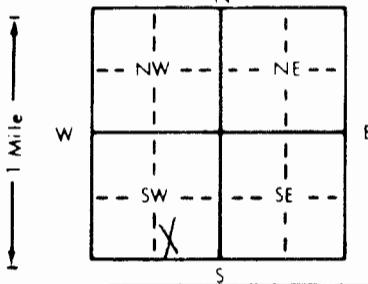

Depth(s) Groundwater Encountered 1. ft. 2. ft. 3. ft. WELL'S STATIC WATER LEVEL ft. below land surface measured on mo/day/yr Pump test data: Well water was ft after hours pumping gpm Est. Yield gpm: Well water was ft after hours pumping gpm Bore Hole Diameter 7.44 in. to 15 ft. and in to ft. WELL WATER TO BE USED AS: 5 Public water supply 8 Air conditioning 11 Injection well 1 Domestic 3 Feedlot 6 Oil field water supply 9 Dewatering 12 Other (Specify below) 2 Irrigation 4 Industrial 7 Lawn and garden only 10 Monitoring well Was a chemical/bacteriological sample submitted to Department? Yes No If yes, mo/day/yr sample was submitted Water Well Disinfected? Yes No

5 TYPE OF BLANK CASING USED: 1 Steel 3 RMP (SR) 5 Wrought iron 8 Concrete tile CASING JOINTS: Glued Clamped 2 Brass 4 Galvanized steel 6 Asbestos-Cement 9 Other (specify below) Welded 7 Fiberglass Threaded

Blank casing diameter 2 in. to 5 ft. Dia in. to ft. Dia in. to ft. Casing height above land surface 0 in., weight Sched 40 lbs. ft. Wall thickness or gauge No.

TYPE OF SCREEN OR PERFORATION MATERIAL: 1 Steel 3 Stainless steel 5 Fiberglass 8 RMP (SR) 10 Asbestos-cement 2 Brass 4 Galvanized steel 6 Concrete tile 9 ABS 11 Other (specify) 12 None used (open hole)

SCREEN OR PERFORATION OPENINGS ARE: 1 Continuous slot 2 Louvered shutter 3 Mill slot 0/0 4 Key punched 5 Gauzed wrapped 6 Wire wrapped 7 Torch cut 8 Saw cut 9 Drilled holes 10 Other (specify) 11 None (open hole)

SCREEN-PERFORATED INTERVALS: From 1.5 ft. to 5 ft. From ft. to ft. From ft. to ft. GRAVEL PACK INTERVALS: From 1.5 ft. to 3.5 ft. From ft. to ft. From ft. to ft.

6 GROUT MATERIAL: 1 Neat cement 2 Cement grout 3 Bentonite 4 Other Grout Intervals: From 1.5 ft. to 6 ft. From 3.5 ft. to 1.5 ft. From ft. to ft.

What is the nearest source of possible contamination: 1 Septic tank 2 Sewer lines 3 Watertight sewer lines 4 Lateral lines 5 Cess pool 6 Seepage pit 7 Pit privy 8 Sewage lagoon 9 Feedyard 10 Livestock pens 11 Fuel storage 12 Fertilizer storage 13 Insecticide storage 14 Abandoned water well 15 Oil well/Gas well 16 Other (specify below)

Direction from well? South How many feet? 40'

FROM	TO	LITHOLOGIC LOG	FROM	TO	PLUGGING INTERVALS
0	.5	CONCRETE			
.5	1.0	CRUSHED ROCK SUBGRADE			
1.0	13.5'	LIMESTONE GRAVEL (FILL)			
13.5'	15'	DK GREENISH-GRAY, SATURATED			
		Flush Mount			

7 CONTRACTOR'S OR LANDOWNER'S CERTIFICATION: This water well was (1) constructed, (2) reconstructed, or (3) plugged under my jurisdiction and was completed on (mo/day/yr) 1-19-97 and this record is true to the best of my knowledge and belief. Kansas Water Well Contractor's License No. 575 This Water Well Record was completed on (mo/day/yr) 2-9-97 under the business name of KURTZ ENVIRONMENTAL SERVICE by (signature)