

Wyandotte


S B # 3

1 LOCATION OF WATER WELL: County ~~Leavenworth~~ Fraction SW 1/4 SE 1/4 SW 1/4 Section Number 36 Township Number T 10 R 24 Range Number R 24

Distance and direction from nearest town or city street address of well if located within city? 4812 Parallel Parkway Kansas City KS

2 WATER WELL OWNER: FINE OIL & CHEMICAL RR# St. Address, Box # PO Box 2126 City, State, ZIP Code Dallas TX 75211 Board of Agriculture, Division of Water Resources Application Number:

3 LOCATE WELL'S LOCATION WITH AN "X" IN SECTION BOX:

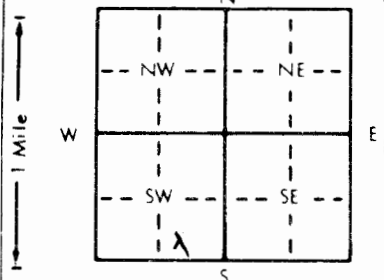

4 DEPTH OF COMPLETED WELL: ft. ELEVATION: Depth(s) Groundwater Encountered 1 ft. 2 ft. 3 ft. WELL'S STATIC WATER LEVEL ft. below land surface measured on mo day yr Pump test data: Well water was ft after hours pumping gpm Est. Yield gpm Well water was ft after hours pumping gpm Bore Hole Diameter 7/4 in. to 15 ft. and in to ft. WELL WATER TO BE USED AS: 5 Public water supply 8 Air conditioning 11 Injection well 1 Domestic 3 Feedlot 6 Oil field water supply 9 Dewatering 10 Other (Specify below) 2 Irrigation 4 Industrial 7 Lawn and garden only 10 Monitoring well Soil Boring Was a chemical bacteriological sample submitted to Department? Yes No If yes, mo day yr sample was submitted Water Well Disinfected? Yes No

5 TYPE OF BLANK CASING USED: 1 Steel 3 RMP (SR) 5 Wrought iron 8 Concrete tile CASING JOINTS: Glued Clamped 2 PVC 4 ABS 6 Asbestos-Cement 9 Other (specify below) Welded Threaded Blank casing diameter in. to ft. Dia in. to ft. Dia in. to ft. Casing height above land surface in. weight lbs. ft Wall thickness or gauge No. TYPE OF SCREEN OR PERFORATION MATERIAL: 1 Steel 3 Stainless steel 5 Fiberglass 8 RMP (SR) 10 Asbestos-cement 2 Brass 4 Galvanized steel 6 Concrete tile 9 ABS 11 Other (specify) 12 None used (open hole) SCREEN OR PERFORATION OPENINGS ARE: 1 Continuous slot 3 Mill slot 5 Gauzed wrapped 8 Saw cut 11 None (open hole) 2 Louvered shutter 4 Key punched 6 Wire wrapped 9 Drilled holes 10 Other (specify) 7 Torch cut SCREEN-PERFORATED INTERVALS: From ft. to ft. From ft. to ft. From ft. to ft. GRAVEL PACK INTERVALS: From ft. to ft. From ft. to ft. From ft. to ft.

6 GROUT MATERIAL: 1 Neat cement 2 Cement grout 3 Bentonite 4 Other Grout Intervals: From ft. to ft. From ft. to ft. From ft. to ft. What is the nearest source of possible contamination: 1 Septic tank 4 Lateral lines 7 Pit privy 10 Livestock pens 14 Abandoned water well 2 Sewer lines 5 Cess pool 8 Sewage lagoon 12 Fertilizer storage 15 Oil well/Gas well 3 Watertight sewer lines 6 Seepage pit 9 Feedyard 13 Insecticide storage 16 Other (specify below)

Direction from well? West How many feet? 20'

FROM	TO	LITHOLOGIC LOG	FROM	TO	PLUGGING INTERVALS
0"	5"	CONCRETE			15' - 14'
5"	140	Sub grade Fill			28 Gallons
140	7.5	olive gray w/light Ben			CEMENT GROUT
7.5	7.5	olive gray clayey silt			about w/58 Ben t.
7.5	9.5	Dark Gray clayey			
9.5	15.0	Fine sandy clay			1' - 0' Surface Concrete

7 CONTRACTOR'S OR LANDOWNER'S CERTIFICATION: This water well was (1) constructed, (2) reconstructed, or (3) plugged under my jurisdiction and was completed on (mo day year) 1-11-97 and this record is true to the best of my knowledge and belief. Kansas Water Well Contractor's License No. 575 This Water Well Record was completed on (mo day yr) 2-13-97 under the business name of Kurtz Environmental Service by (signature)

INSTRUCTIONS: Use typewriter or ball point pen. PLEASE PRESS FIRMLY and PRINT clearly. Please fill in blanks, underline or circle the correct answers. Send top three copies to Kansas Department of Health and Environment, Bureau of Water, Topeka, Kansas 66620-0001. Telephone: 913-296-5545. Send one to WATER WELL OWNER and retain one for your records.