

CORRECTION(S) TO WATER WELL RECORD (WWC-5)

(to rectify lacking or incorrect information)

County: Wyandotte

Location listed as:

Location changed to:

Section-Township-Range: 31-10S-35W

32-10S-24E

Fraction ($\frac{1}{4}$ $\frac{1}{4}$ $\frac{1}{4}$): SE SW SE

SW SW SW

Other changes: Initial statements: _____

Changed to: _____

Comments: _____

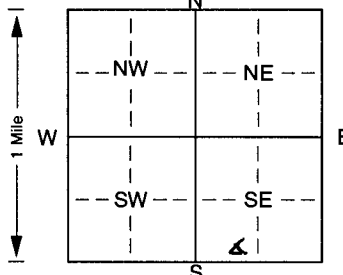
verification method: Well owner's address, Kansas City city map,
and Wolcott 1:24,000 topo map.

initials: DRK date: 5/6/2003

1 LOCATION OF WATER WELL: Fraction SE 1/4 SW 1/4 SE 1/4 Section Number 31 Township Number T 10 S Range Number R 35 E
 County: Wagonette

Distance and direction from nearest town or city street address of well if located within city?

2 WATER WELL OWNER: Quik Trip #172
 RR#, St. Address, Box #: 8200 Parallel Parkway Board of Agriculture, Division of Water Resources
 City, State, ZIP Code: Kansas City, KS Application Number: SB-3/mw-7

3 LOCATE WELL'S LOCATION WITH AN "X" IN SECTION BOX:

 4 DEPTH OF COMPLETED WELL: 10 ft. ELEVATION: ft.
 Depth(s) Groundwater Encountered 1. ft. 2. ft. 3. ft.
 WELL'S STATIC WATER LEVEL: 0.0 ft. below land surface measured on mo/day/yr ft.
 Pump test data: Well water was ft. after hours pumping gpm
 Est. Yield gpm: Well water was ft. after hours pumping gpm
 Bore Hole Diameter: 8 in. to 10 ft., and in. to ft.
 WELL WATER TO BE USED AS: 5 Public water supply 8 Air conditioning 11 Injection well
 1 Domestic 3 Feedlot 6 Oil field water supply 9 Dewatering 12 Other (Specify below)
 2 Irrigation 4 Industrial 7 Domestic (lawn & garden) 10 Monitoring well mw-7
 Was a chemical/bacteriological sample submitted to Department? Yes. No. ; If yes, mo/day/yr sample was submitted
 Water Well Disinfected? Yes

5 TYPE OF BLANK CASING USED: 5 Wrought iron 8 Concrete tile CASING JOINTS: Glued. Clamped.
 1 Steel 3 RMP (SR) 6 Asbestos-Cement 9 Other (specify below) Welded
PVC 4 ABS 7 Fiberglass ~~Threaded~~
 Blank casing diameter: 2 in. to 10 ft., Dia in. to ft., Dia in. to ft.
 Casing height above land surface: NA in., weight lbs./ft. Wall thickness or gauge No. 40
 TYPE OF SCREEN OR PERFORATION MATERIAL: PVC 10 Asbestos-cement
 1 Steel 3 Stainless steel 5 Fiberglass 8 RMP (SR) 11 Other (specify)
 2 Brass 4 Galvanized steel 6 Concrete tile 9 ABS 12 None used (open hole)
 SCREEN OR PERFORATION OPENINGS ARE: 5 Gauzed wrapped 8 Saw cut 11 None (open hole)
 1 Continuous slot 3 Mill slot 6 Wire wrapped 9 Drilled holes
 2 Louvered shutter 4 Key punched 7 Torch cut 10 Other (specify) ft.
 SCREEN-PERFORATED INTERVALS: From: 10 ft. to 4.5 ft., From ft. to ft.
 From: ft. to ft., From ft. to ft.
 GRAVEL PACK INTERVALS: From: 10 ft. to 4.0 ft., From ft. to ft.
 From: ft. to ft., From ft. to ft.

6 GROUT MATERIAL: Neat cement 2 Cement grout 3 Bentonite 4 Other
 Grout Intervals: From: 4 ft. to 1 ft., From 1 ft. to 0 ft., From ft. to ft.
 What is the nearest source of possible contamination:
 1 Septic tank 4 Lateral lines 7 Pit privy 11 Fuel storage 10 Livestock pens 14 Abandoned water well
 2 Sewer lines 5 Cess pool 8 Sewage lagoon 12 Fertilizer storage 15 Oil well/Gas well
 3 Watertight sewer lines 6 Seepage pit 9 Feedyard 13 Insecticide storage 16 Other (specify below)
 Direction from well? How many feet?

FROM	TO	LITHOLOGIC LOG	FROM	TO	PLUGGING INTERVALS
0	10	Clay. Petroleum about 7-9' below ground. No water observed.			/
10		Limestone Bedrock			

7 CONTRACTOR'S OR LANDOWNER'S CERTIFICATION: This water well was (1) constructed, (2) reconstructed, or (3) plugged under my jurisdiction and was completed on (mo/day/year) 8/17/01 and this record is true to the best of my knowledge and belief. Kansas Water Well Contractor's Licence No. 650 This Water Well Record was completed on (mo/day/yr) under the business name of Outstanding Field Services by (signature)



4400 College Blvd Suite 190
Overland Park, KS 66211

LOG OF BORING SB-3/MW-7

PAGE 1 of 1

PROJECT NAME:	QuikTrip #172	DATE:	8/17/01
PROJECT NUMBER:	825335	DEPTH TO WATER:	Dry
LOCATION:	8200 Parallel Parkway, Kansas City, KS	TOTAL DEPTH:	10 feet
LOGGED BY:	Eric Gorman	METHOD:	Hollow Stem Auger
DRILLING CONTRACTOR:	Deffenbaugh	DRILLER:	

DEPTH feet	SAMPLE NUMBER	SAMPLE INTERVAL feet	GEOLOGIC DESCRIPTION	SOIL CLASS	PID READINGS ppm	GRAPHIC LOG: MONITORING WELL	REMARKS
1					10		
2							
3							
4							
5		0-5	clay, hard, dry, brown with some organics and some iron staining, low plasticity, no odor		90		
6				CL			
7	////	5-7	same as above, increase to platy structure, grey and brown		1600		
8	////						
9	////	7-9	dark brown with petroleum odor	CL			
10		9-10	same as above, strong petroleum odor				
11			Total Depth - 10 feet - refusal limestone				
12			//// Samples SB-3 7-9				
13							
14							
15							
16							
17							
18							
19							
20							

bentonite
 sand
 screen
 ben/cem slurry
 cement

RECEIVE
 APR 18 2002
BUREAU OF WATI