

| | | | | | |
|---|-------------------------|----------------------|----------------|-----------------|--------------|
| 1 | LOCATION OF WATER WELL: | Fraction | Section Number | Township Number | Range Number |
| | County: Wyandotte | SW 1/4 SE 1/4 NW 1/4 | 30 | 30 10 | 24 E |

Distance and direction from nearest town or city street address of well if located within city?
 3488 W. Drive, KC, KS

| | | |
|---|--|---|
| 2 | WATER WELL OWNER: Wyandotte County | MW-3 |
| | RR #, St. Address, Box #: 2488 W. Drive | Board of Agriculture, Division of Water Resources |
| | City, State, ZIP Code: Kansas City, KS 66109 | Application Number: |

3 MARK WELL'S LOCATION WITH AN "X" IN SECTION BOX:

| | | |
|----|--|----|
| N | | |
| | | |
| NW | | NE |
| X | | |
| SW | | SE |
| S | | |

4 DEPTH OF WELL 16.70 ft

WELL'S STATIC WATER LEVEL ft.

WELL WAS USED AS:

| | | |
|--------------|----------------------------|--------------------|
| 1 Domestic | 5 Public Water Supply | 9 Dewatering |
| 2 Irrigation | 6 Oil Field Water Supply | 10 Monitoring Well |
| 3 Feedlot | 7 Domestic (Lawn & Garden) | 11 Injection Well |
| 4 Industrial | 8 Air Conditioning | 12 Other |

Was a chemical / bacteriological sample submitted to Department? Yes No

If yes, mo/day/yr sample was submitted

Water Well Disinfected: Yes No

5 TYPE OF BLANK CASING USED:

| | | | | |
|---------|------------|-------------------|-----------------|-------------------------|
| 1 Steel | 3 RMP (SR) | 5 Wrought | 7 Fiberglass | 9 Other (Specify below) |
| 2 PVC | 4 ABS | 6 Asbestos-Cement | 8 Concrete Tile | |

Blank casing diameter 2 in. Was casing pulled? Yes No If yes, how much 16'

Casing height above or below land surface 6 in.

6 GROUT PLUG MATERIAL: 1 Neat cement 2 Cement grout 3 Bentonite 4 Other

Grout Plug Intervals: From 16 ft. to 1 ft., From ft. to ft., From to ft.

What is the nearest source of possible contamination:

| | | | |
|--------------------------|-------------------|-------------------------|--------------------------|
| 1 Septic tank | 6 Seepage pit | 11 Fuel storage | 16 Other (specify below) |
| 2 Sewer lines | 7 Pit privy | 12 Fertilizer storage | |
| 3 Watertight sewer lines | 8 Sewage lagoon | 13 Insecticide storage | |
| 4 Lateral lines | 9 Feedyard | 14 Abandoned water well | |
| 5 Cess Pool | 10 Livestock pens | 15 Oil well/Gas well | |

Direction from well? How many feet?

| FROM | TO | PLUGGING MATERIALS |
|------|----|--------------------|
| 16' | 1' | Bentonite |
| 1' | 0' | Gravel |
| | | |
| | | |
| | | |
| | | |

7 CONTRACTOR'S OR LANDOWNER'S CERTIFICATION: This water well was plugged under my jurisdiction and was completed on (mo/day/year) 12/18/02 and this record is true to the best of my knowledge and belief. Kansas Water Well Contractor's License No. 650 This Water Well Record was completed on (mo/day/year) 1/19/04 under the business name of Knightly Environmental, Inc. by (signature) John Knightly

INSTRUCTIONS: Use typewriter or ball point pen. Please press firmly and print clearly. Please fill in blanks, underline or circle the correct answers. Send top three copies to Kansas Department of Health and Environment, Bureau of Water, Topeka, Kansas 66620-0001. Telephone: 785/296-3565. Send one to Water Well Owner and retain one for your records.

RECEIVED


JAN 21 2004

BUREAU OF WATER

Wooded Area


Land Clearing

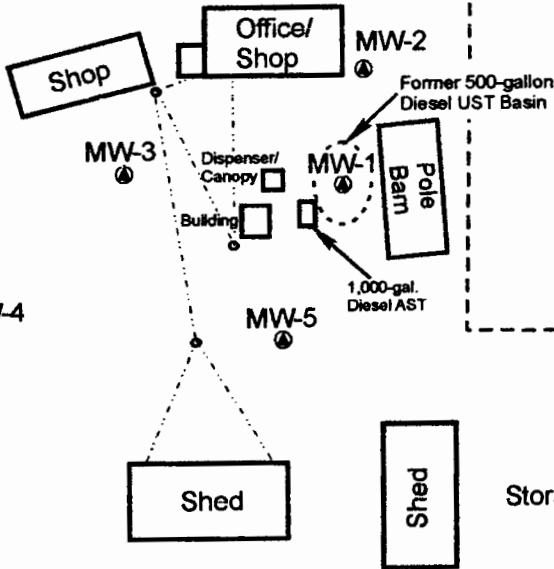

Property Line

Storage Yard

Wooded Area

Road

Wooded Area

Generalized
Groundwater
Flow Direction

Wooded Area




**Knightly
Environmental
Incorporated**
Lenexa, Kansas

KEI Job No.: 69-18

Date: 1/19/04

Notes

- ⊕ Boring Location
- ⊙ Monitoring Well Location
- OHE- Overhead Power (approx. Location)

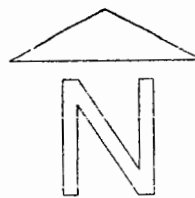

0 ft. 100

Note: Scale Approximate

Figure 1

**Wyandotte County Parks
Kansas City, Kansas**

Site Plan