


1 LOCATION OF WATER WELL:	Fraction	Section Number	Township Number	Range Number
County: <u>Wyandotte</u>	<u>N 1/4 NW 1/4 NE 1/4</u>	<u>32</u>	<u>10 S</u>	<u>24</u> EAW

Distance and direction from nearest town or city street address of well if located within city?
7647 Leavenworth Rd Kc. ks 66109

2 WATER WELL OWNER: <u>CLARKS #1580</u>	Board of Agriculture, Division of Water Resources
RR #, St. Address, Box #: <u>7647 Leavenworth Rd</u>	Application Number: <u>N/A</u>
City, State, ZIP Code: <u>Kc, KS 66109</u>	<u>MW-6</u>

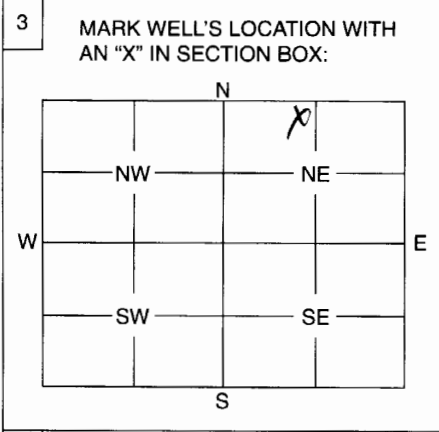

4 DEPTH OF WELL 35 ft.

WELL'S STATIC WATER LEVEL 26 ft. while Drilling

WELL WAS USED AS:

1 Domestic	5 Public Water Supply	9 Dewatering
2 Irrigation	6 Oil Field Water Supply	<input checked="" type="checkbox"/> 10 Monitoring Well
3 Feedlot	7 Domestic (Lawn & Garden)	11 Injection Well
4 Industrial	8 Air Conditioning	12 Other

Was a chemical / bacteriological sample submitted to Department? Yes No

If yes, mo/day/yr sample was submitted

Water Well Disinfected: Yes No

5 TYPE OF BLANK CASING USED: 15ft casing 20ft screen

1 Steel	3 RMP (SR)	5 Wrought	7 Fiberglass	9 Other (Specify below)
<input checked="" type="checkbox"/> PVC	4 ABS	6 Asbestos-Cement	8 Concrete Tile	

Blank casing diameter 2 in. Was casing pulled? Yes No If yes, how much 35

Casing height above or below land surface FLUSH in.

6 GROUT PLUG MATERIAL: 1 Neat cement 2 Cement grout Bentonite 4 Other

Grout Plug Intervals: From 0 ft. to 3.5 ft., From ft. to ft., From to ft.

What is the nearest source of possible contamination:

1 Septic tank	6 Seepage pit	<input checked="" type="checkbox"/> Fuel storage	16 Other (specify below)
2 Sewer lines	7 Pit privy	12 Fertilizer storage	
3 Watertight sewer lines	8 Sewage lagoon	13 Insecticide storage	
4 Lateral lines	9 Feedyard	14 Abandoned water well	
5 Cess pool	10 Livestock pens	15 Oil well/Gas well	

Direction from well? How many feet?

FROM	TO	PLUGGING MATERIALS
0	35	Bentonite

well pulled, overdrilled and back filled with Bentonite

7 CONTRACTOR'S OF LANDOWNER'S CERTIFICATION: This water well was plugged under my jurisdiction and was completed on (mo/day/year) 9/20/05 and this record is true to the best of my knowledge and belief. Kansas Water Well Contractor's License No. 650 This Water Well Record was completed on (mo/day/year) 9/27/05 under the business name of DFS by (signature) [Signature]