


1 LOCATION OF WATER WELL: Fraction NE NW 1/4 NE 1/4 Section Number 32 Township Number 10 South Range Number 24 East E/W  
 County: WYANDOTT

Distance and direction from nearest town or city street address of well if located within city?  
7647 LEAVENWORTH ROAD K.C. KS 66109

2 WATER WELL OWNER: CLARKS #1580 Board of Agriculture, Division of Water Resources  
 RR #, St. Address, Box #: 7647 Leavenworth Rd Application Number: MW-1  
 City, State, ZIP Code: K.C. KS 66109

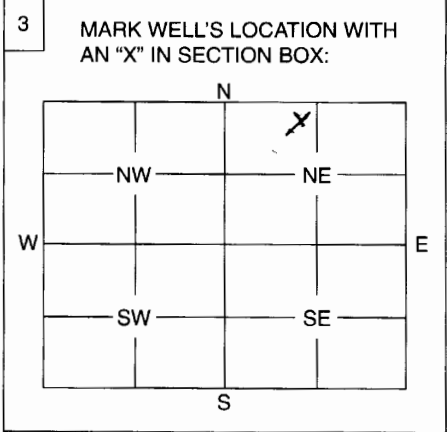

4 DEPTH OF WELL ..... 30 ..... ft.  
 WELL'S STATIC WATER LEVEL ..... 29 ..... ft. while drilled.  
 WELL WAS USED AS:  
 1 Domestic 2 Irrigation 3 Feedlot 4 Industrial 5 Public Water Supply 6 Oil Field Water Supply 7 Domestic (Lawn & Garden) 8 Air Conditioning 9 Dewatering 10 Monitoring Well 11 Injection Well 12 Other .....  
 Was a chemical / bacteriological sample submitted to Department? Yes ..... No X.....  
 If yes, mo/day/yr sample was submitted .....  
 Water Well Disinfected: Yes ..... No X.....

5 TYPE OF BLANK CASING USED: 15 ft of casing 15 ft screen all pulled  
 1 Steel 2 RMP (SR) 3 Wrought 4 Fiberglass 5 Other (Specify below)  
6 PVC 7 ABS 8 Asbestos-Cement 9 Concrete Tile  
 Blank casing diameter 2 in. Was casing pulled? Yes X No ..... If yes, how much 30 ft  
 Casing height above or below land surface FLUSH in.

6 GROUT PLUG MATERIAL: 1 Neat cement 2 Cement grout 3 Bentonite 4 Other .....  
 Grout Plug Intervals: From 0 ft. to 30 ft., From ..... ft. to ..... ft., From ..... to ..... ft.  
 What is the nearest source of possible contamination:  
 1 Septic tank 2 Sewer lines 3 Watertight sewer lines 4 Lateral lines 5 Cess pool 6 Seepage pit 7 Pit privy 8 Sewage lagoon 9 Feedyard 10 Livestock pens 11 Fuel storage 12 Fertilizer storage 13 Insecticide storage 14 Abandoned water well 15 Oil well/Gas well 16 Other (specify below) .....  
 Direction from well? ..... How many feet? .....

FROM	TO	PLUGGING MATERIALS
<u>0</u>	<u>30</u>	<u>Bentonite</u>

*Well was pulled,  
 over drilled & back filled  
 with Bentonite chips*

7 CONTRACTOR'S OR LANDOWNER'S CERTIFICATION: This water well was plugged under my jurisdiction and was completed on (mo/day/year) 9/20/05 and this record is true to the best of my knowledge and belief. Kansas Water Well Contractor's License No. 650 This Water Well Record was completed on (mo/day/year) 9/27/05 under the business name of D.F.S.  
 by (signature) Ron Newell