


1 LOCATION OF WATER WELL:	Fraction	Section Number	Township Number	Range Number
County: <b>Wyandotte</b>	<b>SW ¼ SE ¼ SW ¼</b>	<b>36</b>	<b>10S</b>	<b>24E</b>

Distance and direction from nearest town or city street address of well if located within city?

**FINA #9477, 4812 Parallel Parkway, Kansas City**

2 WATER WELL OWNER: <b>Total Petrochemicals USA</b>	Board of Agriculture, Division of Water Resources
RR#, St. Address, Box # <b>1201 Louisiana Street, Suite 180</b>	Application Number: _____
City, State, ZIP Code : <b>Houston, Texas 77002</b>	

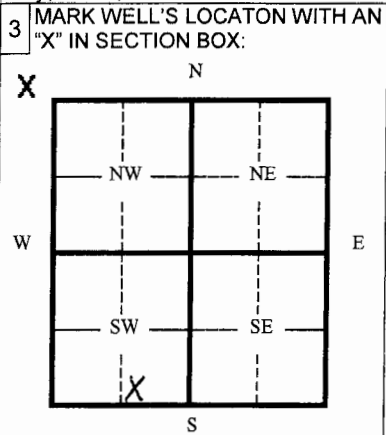

4 DEPTH OF WELL \_\_\_\_\_ **11.9** ft.

WELL'S STATIC WATER LEVEL \_\_\_\_\_ **Unknown** ft.

WELL WAS USED AS:

1 Domestic	5 Public Water Supply	9 Dewatering
2 Irrigation	6 Oil Field Water Supply	<input checked="" type="radio"/> 10 Monitoring Well
3 Feedlot	7 Lawn and Garden (domestic)	11 Injection Well
4 Industrial	8 Air Conditioning	12 Other _____

Was a chemical/bacteriological sample submitted to Department? Yes \_\_\_\_\_ No

If yes, mo/day/yr sample was submitted \_\_\_\_\_

Water Well Disinfected: Yes \_\_\_\_\_ No

5 TYPE OF BLANK CASING USED:

1 Steel	3 RMP (SR)	5 Wrought	7 Fiberglass	9 Other (specify below)
<input checked="" type="radio"/> 2 PVC	4 ABC	6 Asbestos-Cement	8 Concrete Tile	

Blank casing diameter \_\_\_\_\_ **2** in. Was casing pulled? Yes  No \_\_\_\_\_ If yes, how much **Overdrilled entire casing/screen**

Casing height above or below land surface \_\_\_\_\_ **0** in.

6 GROUT PLUG MATERIAL: 1 Neat cement 2 Cement grout  3 Bentonite 4 Other \_\_\_\_\_

Grout Plug Intervals From **0.5** ft. to **12** ft. From \_\_\_\_\_ ft. to \_\_\_\_\_ ft. From \_\_\_\_\_ ft. to \_\_\_\_\_ ft.

What is the nearest source of possible contamination:

1 Septic tank	6 Seepage pit	<input checked="" type="radio"/> 11 Fuel storage	16 Other (specify below)
2 Sewer lines	7 Pit privy	12 Fertilizer storage	
3 Watertight sewer lines	8 Sewage lagoon	13 Insecticide storage	
4 Lateral lines	9 Feedyard	14 Abandoned water well	
5 Cess Pool	10 Livestock pens	15 Oil well/ Gas well	

Direction from well? **North** How many feet? **27**

FROM	TO	CODE	PLUGGING MATERIALS
<b>0 ft</b>	<b>0.5 ft</b>		<b>Concrete</b>
<b>0.5 ft</b>	<b>12 ft</b>		<b>3/8" diameter bentonite chips</b>

7 CONTRACTOR'S OR LANDOWNER'S CERTIFICATION: This water well was plugged under my jurisdiction and was completed on (mo/day/yr) \_\_\_\_\_ **7/26/06** \_\_\_\_\_ and this record is true to the best of my knowledge and belief. Kansas Water Well Contractor's License No. \_\_\_\_\_ **616** \_\_\_\_\_ This Water Well Record was completed on (mo/day/yr) \_\_\_\_\_ **8/15/06** \_\_\_\_\_ under the business name of \_\_\_\_\_ **Thiele Geotech, Inc.**

by (signature) \_\_\_\_\_ *D. J. [Signature]* \_\_\_\_\_

INSTRUCTIONS: Please fill in blanks and circle the correct answers. Send three copies to Kansas Department of Health and Environment, Bureau of Water, 1000 S W Jackson St., Ste. 420, Topeka, Kansas 66620-0001. Telephone: 785-296-3565. Send one to Water Well Owner and retain one for your records.