


1 LOCATION OF WATER WELL: Fraction	Section Number	Township Number	Range Number
County: <b>Wyandotte</b> SW 1/4 SE 1/4 SW 1/4	<b>36</b>	<b>10S</b>	<b>24E</b>

Distance and direction from nearest town or city street address of well if located within city?

**FINA #9477, 4812 Parallel Parkway, Kansas City**

2 WATER WELL OWNER: <b>Total Petrochemicals USA</b>	Board of Agriculture, Division of Water Resources Application Number:
RR#, St. Address, Box # <b>1201 Louisiana Street, Suite 180</b>	
City, State, ZIP Code : <b>Houston, Texas 77002</b>	

3 MARK WELL'S LOCATION WITH AN "X" IN SECTION BOX:

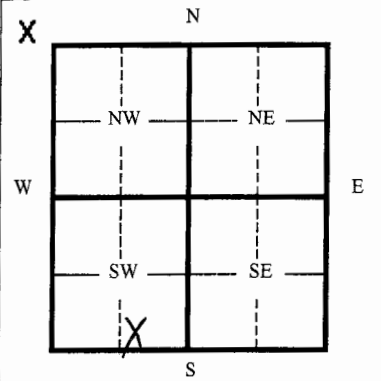

4 DEPTH OF WELL **15** ft.

WELL'S STATIC WATER LEVEL **Unknown** ft.

WELL WAS USED AS:

- |              |                              |   |
|--------------|------------------------------|---|
| 1 Domestic   | 5 Public Water Supply        | 9 Dewatering  |
| 2 Irrigation | 6 Oil Field Water Supply     | <input checked="" type="radio"/> 10 Monitoring Well |
| 3 Feedlot    | 7 Lawn and Garden (domestic) | 11 Injection Well                                   |
| 4 Industrial | 8 Air Conditioning           | 12 Other _____                                      |

Was a chemical/bacteriological sample submitted to Department? Yes \_\_\_ No

If yes, mo/day/yr sample was submitted \_\_\_\_\_

Water Well Disinfected: Yes \_\_\_ No

5 TYPE OF CASING USED:

- |  |            |                   |                 |                         |
|--|------------|-------------------|-----------------|-------------------------|
| 1 Steel                                | 3 RMP (SR) | 5 Wrought         | 7 Fiberglass    | 9 Other (specify below) |
| <input checked="" type="radio"/> 2 PVC | 4 ABC      | 6 Asbestos-Cement | 8 Concrete Tile |                         |

Blank casing diameter **2** in. Was casing pulled? Yes  No \_\_\_ If yes, how much **Overdrilled entire casing/screen**

Casing height above or below land surface **0** in.

6 GROUT PLUG MATERIAL: 1 Neat cement 2 Cement grout  3 Bentonite 4 Other \_\_\_\_\_

Grout Plug Intervals From **0.5** ft. to **15** ft. From \_\_\_\_\_ ft. to \_\_\_\_\_ ft. From \_\_\_\_\_ ft. to \_\_\_\_\_ ft.

What is the nearest source of possible contamination:

- |                          |                   |  |                          |
|--------------------------|-------------------|--|--------------------------|
| 1 Septic tank            | 6 Seepage pit     | <input checked="" type="radio"/> 11 Fuel storage | 16 Other (specify below) |
| 2 Sewer lines            | 7 Pit privy       | 12 Fertilizer storage                            | _____                    |
| 3 Watertight sewer lines | 8 Sewage lagoon   | 13 Insecticide storage                           | _____                    |
| 4 Lateral lines          | 9 Feedyard        | 14 Abandoned water well                          | _____                    |
| 5 Cess Pool              | 10 Livestock pens | 15 Oil well/ Gas well                            | _____                    |

Direction from well? **South** How many feet? **40**

FROM	TO	CODE	PLUGGING MATERIALS
<b>0 ft</b>	<b>0.5 ft</b>		<b>Concrete</b>
<b>0.5 ft</b>	<b>15 ft</b>		<b>3/8" diameter bentonite chips</b>

7 CONTRACTOR'S OR LANDOWNER'S CERTIFICATION: This water well was plugged under my jurisdiction and was completed on (mo/day/yr) **7/26/06** and this record is true to the best of my knowledge and belief. Kansas Water Well Contractor's License No. **616** This Water Well Record was completed on (mo/day/yr) **8/15/06** under the business name of **Thiele Geotech, Inc.** by (signature) *D. J. A. E.*

INSTRUCTIONS: Please fill in blanks and circle the correct answers. Send three copies to Kansas Department of Health and Environment, Bureau of Water, 1000 S W Jackson St., Ste. 420, Topeka, Kansas 66620-0001. Telephone: 785-296-3565. Send one to Water Well Owner and retain one for your records.