


1 LOCATION OF WATER WELL: Fraction	Section Number	Township Number	Range Number
County: <b>Wyandotte</b> SW ¼ SE ¼ SW ¼	<b>36</b>	<b>10S</b>	<b>24E</b>

Distance and direction from nearest town or city street address of well if located within city?

**FINA #9477, 4812 Parallel Parkway, Kansas City**

2 WATER WELL OWNER: <b>Total Petrochemicals USA</b>	Board of Agriculture, Division of Water Resources
RR#, St. Address, Box # <b>1201 Louisiana Street, Suite 180</b>	Application Number:
City, State, ZIP Code : <b>Houston, Texas 77002</b>	

3 MARK WELL'S LOCATION WITH AN "X" IN SECTION BOX:

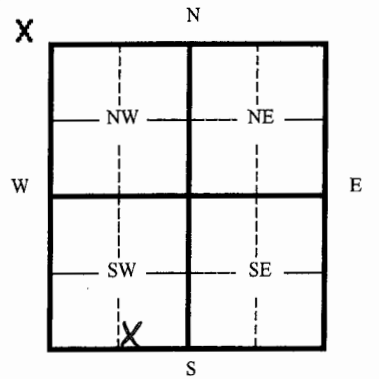

4 DEPTH OF WELL <b>15</b> ft.
WELL'S STATIC WATER LEVEL <b>Unknown</b> ft.

WELL WAS USED AS:

- 1 Domestic
- 2 Irrigation
- 3 Feedlot
- 4 Industrial
- 5 Public Water Supply
- 6 Oil Field Water Supply
- 7 Lawn and Garden (domestic)
- 8 Air Conditioning
- 9 Dewatering
- 10 **Monitoring Well**
- 11 Injection Well
- 12 Other

Was a chemical/bacteriological sample submitted to Department? Yes \_\_\_ No **X**

If yes, mo/day/yr sample was submitted \_\_\_\_\_

Water Well Disinfected: Yes \_\_\_ No **X**

5 TYPE OF BLANK CASING USED:

1 Steel	3 RMP (SR)	5 Wrought	7 Fiberglass	9 Other (specify below)
<b>2 PVC</b>	4 ABC	6 Asbestos-Cement	8 Concrete Tile	

Blank casing diameter **2** in. Was casing pulled? Yes **X** No \_\_\_ If yes, how much **Overdrilled entire casing/screen**

Casing height above or below land surface **0** in.

6 GROUT PLUG MATERIAL: 1 Neat cement 2 Cement grout **3 Bentonite** 4 Other

Grout Plug Intervals From **1** ft. to **15** ft. From \_\_\_ ft. to \_\_\_ ft. From \_\_\_ ft. to \_\_\_ ft.

What is the nearest source of possible contamination:

- 1 Septic tank
- 2 Sewer lines
- 3 Watertight sewer lines
- 4 Lateral lines
- 5 Cess Pool
- 6 Seepage pit
- 7 Pit privy
- 8 Sewage lagoon
- 9 Feedyard
- 10 Livestock pens
- 11 Fuel storage**
- 12 Fertilizer storage
- 13 Insecticide storage
- 14 Abandoned water well
- 15 Oil well/ Gas well
- 16 Other (specify below)

Direction from well? **South** How many feet? **60**

FROM	TO	CODE	PLUGGING MATERIALS
<b>0 ft</b>	<b>1 ft</b>		<b>Compacted silt/clay</b>
<b>1 ft</b>	<b>15 ft</b>		<b>3/8" diameter bentonite chips</b>

7 CONTRACTOR'S OR LANDOWNER'S CERTIFICATION: This water well was plugged under my jurisdiction and was completed on (mo/day/yr) **7/26/06** and this record is true to the best of my knowledge and belief. Kansas Water Well Contractor's License No. **616** This Water Well Record was completed on (mo/day/yr) **8/15/06** under the business name of **Thiele Geotech, Inc.**

by (signature) *D. J. Hall*

INSTRUCTIONS: Please fill in blanks and circle the correct answers. Send three copies to Kansas Department of Health and Environment, Bureau of Water, 1000 S W Jackson St., Ste. 420, Topeka, Kansas 66620-0001. Telephone: 785-296-3565. Send one to Water Well Owner and retain one for your records.