


1 LOCATION OF WATER WELL:	Fraction	Section Number	Township Number	Range Number
County: Wyandotte	SW 1/4 SE 1/4 SW 1/4	36	10S	24E

Distance and direction from nearest town or city street address of well if located within city?

FINA #9477, 4812 Parallel Parkway, Kansas City

2 WATER WELL OWNER:	Total Petrochemicals USA	Board of Agriculture, Division of Water Resources
RR#, St. Address, Box #	1201 Louisiana Street, Suite 180	Application Number:
City, State, ZIP Code	Houston, Texas 77002	

3 MARK WELL'S LOCATION WITH AN "X" IN SECTION BOX:

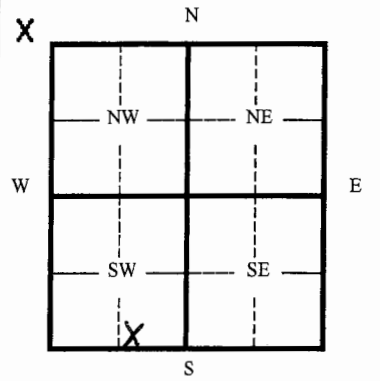

4 DEPTH OF WELL	15	ft.												
WELL'S STATIC WATER LEVEL	Unknown	ft.												
WELL WAS USED AS:	<table border="0"> <tr> <td>1 Domestic</td> <td>5 Public Water Supply</td> <td>9 Dewatering</td> </tr> <tr> <td>2 Irrigation</td> <td>6 Oil Field Water Supply</td> <td><input checked="" type="radio"/> 10 Monitoring Well</td> </tr> <tr> <td>3 Feedlot</td> <td>7 Lawn and Garden (domestic)</td> <td>11 Injection Well</td> </tr> <tr> <td>4 Industrial</td> <td>8 Air Conditioning</td> <td>12 Other</td> </tr>
Was a chemical/bacteriological sample submitted to Department?	Yes	No <input checked="" type="checkbox"/>												
If yes, mo/day/yr sample was submitted	-----													
Water Well Disinfected:	Yes	No <input checked="" type="checkbox"/>												

5 TYPE OF BLANK CASING USED:	<table border="0"> <tr> <td>1 Steel</td> <td>3 RMP (SR)</td> <td>5 Wrought</td> <td>7 Fiberglass</td> <td>9 Other (specify below)</td> </tr> <tr> <td><input checked="" type="radio"/> 2 PVC</td> <td>4 ABC</td> <td>6 Asbestos-Cement</td> <td>8 Concrete Tile</td> <td></td> </tr>
Blank casing diameter	2	in.	Was casing pulled?	Yes <input checked="" type="checkbox"/> No										
Casing height above or below land surface	0	in.	If yes, how much	Overdrilled entire casing/screen										

6 GROUT PLUG MATERIAL:	1 Neat cement	2 Cement grout	<input checked="" type="radio"/> 3 Bentonite	4 Other																				
Grout Plug Intervals	From 1 ft. to 15 ft.	From	ft. to	ft.																				
What is the nearest source of possible contamination:	<table border="0"> <tr> <td>1 Septic tank</td> <td>6 Seepage pit</td> <td><input checked="" type="radio"/> 11 Fuel storage</td> <td>16 Other (specify below)</td> </tr> <tr> <td>2 Sewer lines</td> <td>7 Pit privy</td> <td>12 Fertilizer storage</td> <td></td> </tr> <tr> <td>3 Watertight sewer lines</td> <td>8 Sewage lagoon</td> <td>13 Insecticide storage</td> <td></td> </tr> <tr> <td>4 Lateral lines</td> <td>9 Feedyard</td> <td>14 Abandoned water well</td> <td></td> </tr> <tr> <td>5 Cess Pool</td> <td>10 Livestock pens</td> <td>15 Oil well/ Gas well</td> <td></td> </tr>
Direction from well?	East	How many feet?	46																					

FROM	TO	CODE	PLUGGING MATERIALS
0 ft	1 ft		Compacted silt/clay
1 ft	15 ft		3/8" diameter bentonite chips

7 CONTRACTOR'S OR LANDOWNER'S CERTIFICATION:	This water well was plugged under my jurisdiction and was completed on (mo/day/yr) 7/26/06 and this record is true to the best of my knowledge and belief. Kansas Water Well Contractor's License No. 616 This Water Well Record was completed on (mo/day/yr) 8/15/06 under the business name of Thiele Geotech, Inc.		
by (signature)	<i>[Signature]</i>		

INSTRUCTIONS: Please fill in blanks and circle the correct answers. Send three copies to Kansas Department of Health and Environment, Bureau of Water, 1000 S W Jackson St., Ste. 420, Topeka, Kansas 66620-0001. Telephone: 785-296-3565. Send one to Water Well Owner and retain one for your records.