


1 LOCATION OF WATER WELL: Fraction	Section Number	Township Number	Range Number
County: <b>Wyandotte</b> SW 1/4 SE 1/4 SW 1/4	<b>36</b>	<b>10S</b>	<b>24E</b>

Distance and direction from nearest town or city street address of well if located within city?  
**FINA #9477, 4812 Parallel Parkway, Kansas City**

2 WATER WELL OWNER: **Total Petrochemicals USA**  
 RR#, St. Address, Box # **1201 Louisiana Street, Suite 180** Board of Agriculture, Division of Water Resources  
 City, State, ZIP Code : **Houston, Texas 77002** Application Number:

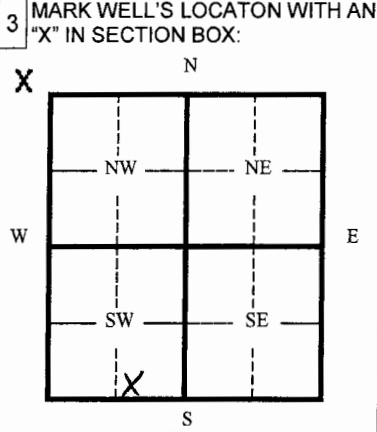

4 DEPTH OF WELL **14.5** ft.  
 WELL'S STATIC WATER LEVEL **Unknown** ft.  
 WELL WAS USED AS:  
 1 Domestic      5 Public Water Supply      9 Dewatering  
 2 Irrigation      6 Oil Field Water Supply      10 Monitoring Well  
 3 Feedlot      7 Lawn and Garden (domestic)      11 Injection Well  
 4 Industrial      8 Air Conditioning      12 Other \_\_\_\_\_  
 Was a chemical/bacteriological sample submitted to Department? Yes \_\_\_\_\_ No **X**  
 If yes, mo/day/yr sample was submitted \_\_\_\_\_  
 Water Well Disinfected: Yes \_\_\_\_\_ No **X**

5 TYPE OF BLANK CASING USED:  
 1 Steel      3 RMP (SR)      5 Wrought      7 Fiberglass      9 Other (specify below)  
 2 PVC      4 ABC      6 Asbestos-Cement      8 Concrete Tile  
 Blank casing diameter **2** in. Was casing pulled? Yes **X** No \_\_\_\_\_ If yes, how much **Overdrilled entire casing/screen**  
 Casing height above or below land surface **0** in.

6 GROUT PLUG MATERIAL: 1 Neat cement      2 Cement grout      3 Bentonite      4 Other \_\_\_\_\_  
 Grout Plug Intervals From **1** ft. to **14.5** ft. From \_\_\_\_\_ ft. to \_\_\_\_\_ ft. From \_\_\_\_\_ ft. to \_\_\_\_\_ ft.  
 What is the nearest source of possible contamination:  
 1 Septic tank      6 Seepage pit      11 Fuel storage      16 Other (specify below)  
 2 Sewer lines      7 Pit privy      12 Fertilizer storage  
 3 Watertight sewer lines      8 Sewage lagoon      13 Insecticide storage  
 4 Lateral lines      9 Feedyard      14 Abandoned water well  
 5 Cess Pool      10 Livestock pens      15 Oil well/ Gas well

Direction from well? **East** How many feet? **60**

FROM	TO	CODE	PLUGGING MATERIALS
0 ft	1 ft		Compacted silt/clay
1 ft	14.5 ft		3/8" diameter bentonite chips

7 CONTRACTOR'S OR LANDOWNER'S CERTIFICATION: This water well was plugged under my jurisdiction and was completed on (mo/day/yr) **7/26/06** and this record is true to the best of my knowledge and belief. Kansas Water Well Contractor's License No. **616** This Water Well Record was completed on (mo/day/yr) **8/15/06** under the business name of **Thiele Geotech, Inc.**  
 by (signature) *D. J. [Signature]*

INSTRUCTIONS: Please fill in blanks and circle the correct answers. Send three copies to Kansas Department of Health and Environment, Bureau of Water, 1000 S W Jackson St., Ste. 420, Topeka, Kansas 66620-0001. Telephone: 785-296-3565. Send one to Water Well Owner and retain one for your records.