

County: Wyandotte Fraction SW SW NW SW Sec. 34 T 10 S R 24 EA

CORRECTION(S) TO WATER WELL COMPLETION RECORD (WWC-5)

(to rectify lacking or incorrect information)

Owner: Hazel Grove Elementary School

Location was listed as:

Location changed to:

Section-Township-Range: None Given

34-10S-24E

Fraction (1/4 1/4 1/4): _____

SW SW NW SW

Other changes: Initial statements: N39 07 9'64"

W0 94 44.026

Changed to: 39° 7.964' = 39.132733

-94° 44.026' = -94.733766

Comments: _____

Verification method: wellsite address, city street map, latitude &

longitude & KGS' "LEO" conversion tool, and mapping tool

& aerial photos on KGS website. initials: DRJ date: 11/15/2013

Submitted by: Kansas Geological Survey, Data Resources Library, 1930 Constant Ave., Lawrence, KS 66047-3726

to: Kansas Dept of Health & Environment, Bureau of Water, 1000 SW Jackson, Suite 420, Topeka, KS 66612-1367.

WATER WELL PLUGGING RECORD Form WWC-5P KSA 82a-1212 ID NO.


1 LOCATION OF WATER WELL: County: Wyandott	Fraction ¼ ¼ ¼ ¼	Section Number	Township Number T S	Range Number <input type="checkbox"/> E <input type="checkbox"/> W
--	------------------------------	----------------	---------------------------	---

Street/Rural Address of Well Location; if unknown, distance & direction from nearest town or intersection: If at owner's address, check here Hazel Grove Elementary

2401 N 67th Street, Kansas City KS

Global Positioning Systems (GPS) information:
 Latitude: N39 07 9' 64" (in decimal degrees)
 Longitude: WO 94 44.026 (in decimal degrees)
 Elevation: 887
 Datum: WGS84, NAD83, NAD27
 Collection Method:
 GPS unit (Make/Model: Garmin Etrex)
 Digital Map/Photo, Topographic Map, Land Survey
 Est. Accuracy: < 3 m, 3-5 m, 5-15 m, > 15 m

2 WATER WELL OWNER:
 RR#, St. Address, Box #:
 City, State ZIP Code:

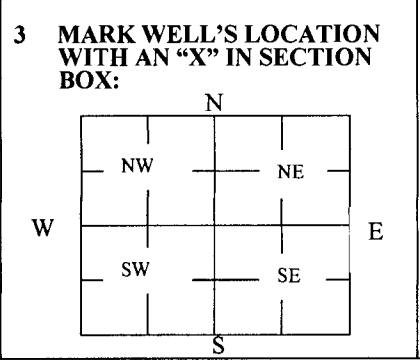

4 DEPTH OF WELL 24 ft.
 WELL'S STATIC WATER LEVEL 15 ft.
 WELL WAS USED AS:
 Domestic Public Water Supply Dewatering
 Irrigation Oil Field Water Supply Monitoring
 Feedlot Domestic (Lawn & Garden) Injection Well
 Industrial Air Conditioning Other _____
 Was a chemical/bacteriological sample submitted to Department? Yes No

5 TYPE OF BLANK CASING USED:

Steel RMP (SR) Wrought Fiberglass Other (Specify below)
 PVC ABS Asbestos-Cement Concrete Tile hand dug and lined with rock

Blank casing diameter _____ in. Was casing pulled? Yes No If yes, how much _____ in.
 Casing height above or below land surface _____ in.

6 GROUT PLUG MATERIAL: Neat cement Cement grout Bentonite Other _____

Grout Plug Intervals: From 6 ft. to 3 ft., From _____ ft. to _____ ft., From _____ to _____ ft.

What is the nearest source of possible contamination:
 Septic tank Seepage pit Fuel Storage Other (specify below)
 Sewer lines Pit privy Fertilizer storage
 Watertight sewer lines Sewage lagoon Insecticide storage
 Lateral lines Feedyard Abandoned water well Direction from well? _____
 Cess pool Livestock pens Oil well/Gas well How many feet? _____

FROM	TO	PLUGGING MATERIALS	FROM	TO	PLUGGING MATERIALS
24	15	chlorinated sand			
15	6	clay, compacted			
6	3	neat cement			
3	0	clay cap			

7 CONTRACTOR'S OR LANDOWNER'S CERTIFICATION: This water well was plugged under my jurisdiction and was completed on (mo/day/year) 07/11/13 and this record is true to the best of my knowledge and belief. Kansas Water Well Contractor's License No. _____. This Water Well Record was completed on (mo/day/year) 07/12/13 under the business name of Douglas Pump Service Inc by (signature) Billy Perry

INSTRUCTIONS: Use typewriter or ballpoint pen. Please press firmly and print clearly. Please fill in blanks, underline or circle the correct answers. Send top three copies to Kansas Department of Health and Environment, Bureau of Water, Geology Section, 1000 SW Jackson St., Ste. 420, Topeka, Kansas 66612-1367. Telephone: 785/296-5524. Send one to Water Well Owner and retain one for your records. Visit us at <http://www.kdheks.gov/waterwell/index.html>.

Check one: White Copy Blue Copy Pink Copy