

## Richard Harper

---

**From:** Brent Bauters <bbauters@Meyer-Najem.com>  
**Sent:** Wednesday, June 04, 2014 8:51 AM  
**To:** Richard Harper  
**Subject:** Water Well Removal at 8900 Parallel Pkwy, Kansas City, KS  
**Attachments:** Water Well - 8900 Paralle Pkwy.pdf; C-02 Existing Conditions Plan 2014-05-06.pdf

Richard,

Thanks again for calling me back this morning regarding the water well located at 8900 Parallel Pkwy., Kansas City, KS 66112. The site of the well is SW QTR of SW Qtr Section 31, Township 10 South; Range 24 E, Latitude 39 deg 7 min 45 sec, Longitude -94 deg, 47 min, 11 sec. Site drawing with approximate well location is attached.

The existing well is dry and has an approximate depth of 10'-0". At the location of the well the new subgrade will be 12'-0" below existing grade, or 2'-0" below the bottom of the well (See attached drawing for reference). As discussed, since the well is being removed in its entirety, no further action or documentation will be required and this email shall serve as record of removal. Thanks again for your help with getting this issue resolved.

Best Regards,



**Brent Bauters**

Project Manager

office: 317.577.0007 | mobile: 317.557.4961

[www.meyer-najem.com](http://www.meyer-najem.com)

BUILDING VALUE. BUILDING SOLUTIONS.


---

This message (and any associated files) is intended only for the use of the individual or entity to which it is addressed and may contain information that is confidential, subject to copyright or constitutes a trade secret. If you are not the intended recipient you are hereby notified that any dissemination, copying or distribution of this message, or files associated with this message, is strictly prohibited. Internet communications cannot be guaranteed to be secure or error-free as information could be intercepted, corrupted, lost, destroyed, arrive late or incomplete, or contain viruses. Therefore, we do not accept responsibility for any errors or omissions that are present in this message, or any attachment, that have arisen as a result of e-mail transmission. Any views or opinions presented are solely those of the author and do not necessarily represent those of the company.

A handwritten signature in blue ink, appearing to read "Brent Bauters".

Well located at 8900 Parallel  
Parkway, Kansas City, KS

Existing Grade

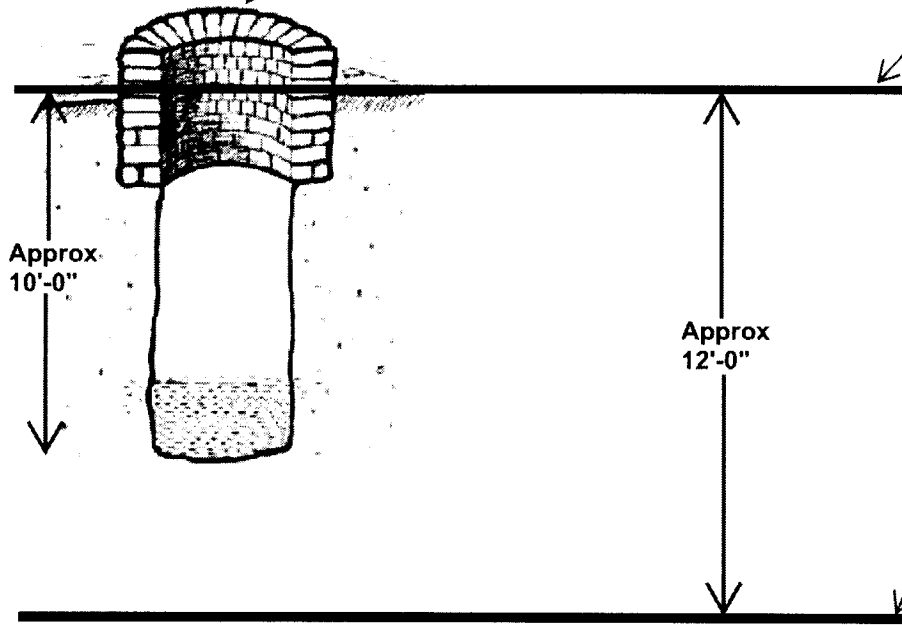


Approx  
10'-0"

Approx  
12'-0"

New Subgrade

### Kansas Water Wells

Statewide View | Zoom to Location | Filter Wells | Label Wells | Classify Wells | Download Wells | Print to PDF | Clear Highlight | Help

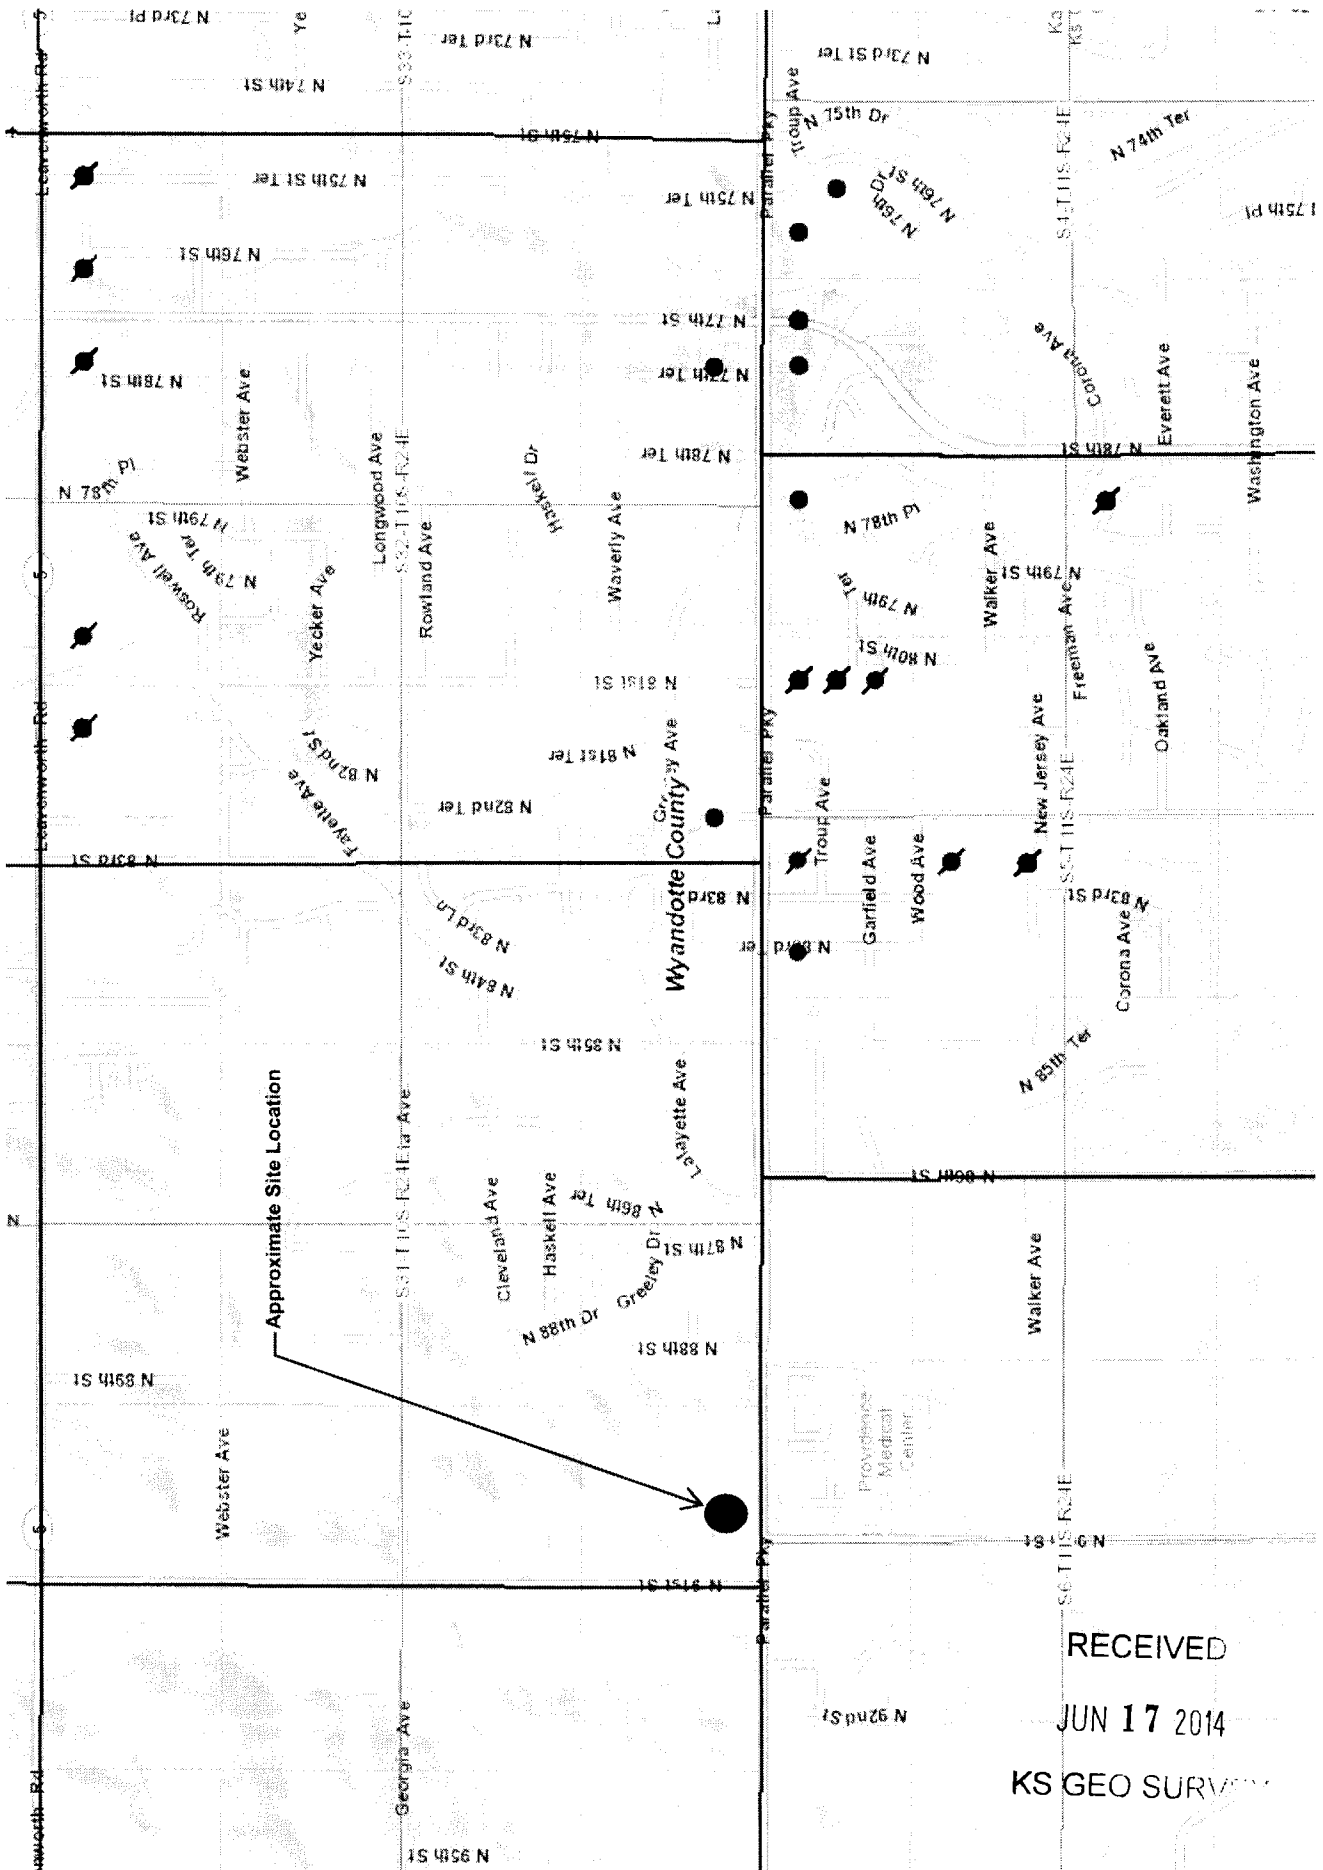

RECEIVED  
JUN 17 2014  
KS GEO SURVEY


PROPERTY LINE  



**811**  
 Know what's below.  
 Call before you dig.


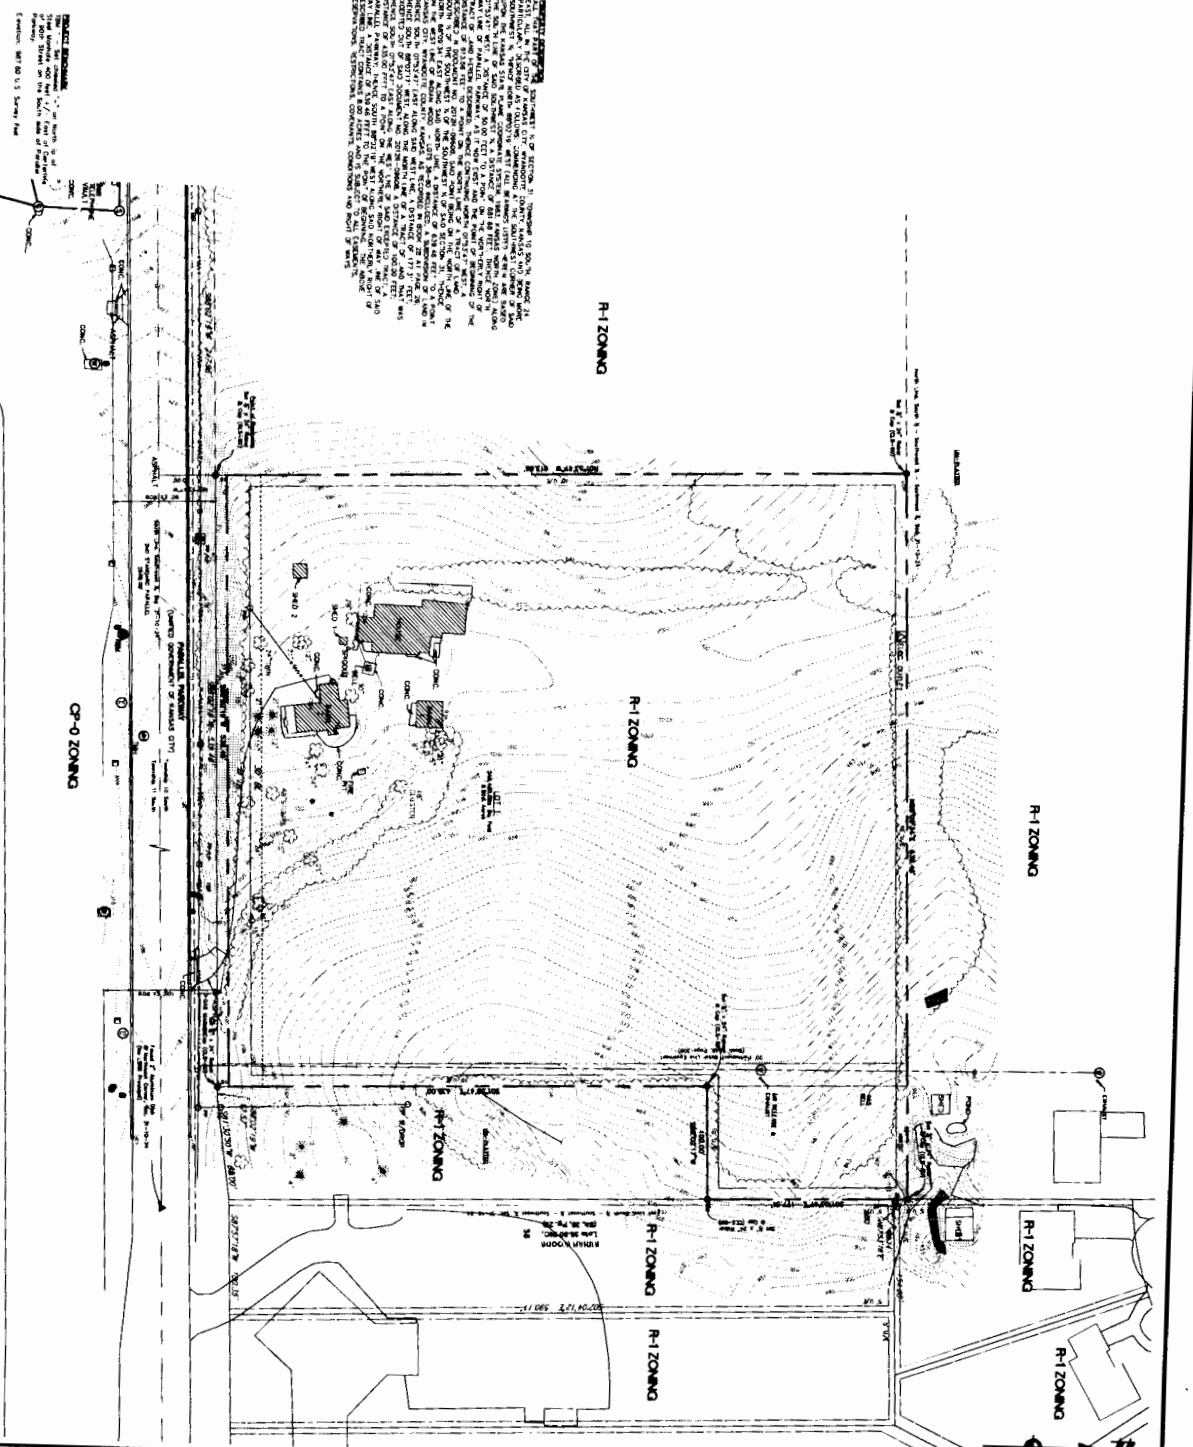


**R-1 ZONING**

**R-1 ZONING**

**R-1 ZONING**

**R-1 ZONING**

**R-1 ZONING**

**R-1 ZONING**

**R-1 ZONING**

**ATWELL**  
 1242 EAST 50TH STREET, SUITE 100  
 WYANDOTTE COUNTY, KANSAS 66202  
 (785) 938-0050  
 WWW.ATWELLINC.COM

CLIENT: HEALTH AND WELLNESS SUITES OF KANSAS CITY, KANSAS CITY, KS  
 PROJECT: FINAL ENGINEERING PLANS  
 DATE: 06/27/2013

PROVIDENCE NORTH  
 PARALLEL PARKWAY & N. 91ST STREET  
 CITY OF KANSAS CITY  
 WYANDOTTE COUNTY, KANSAS


