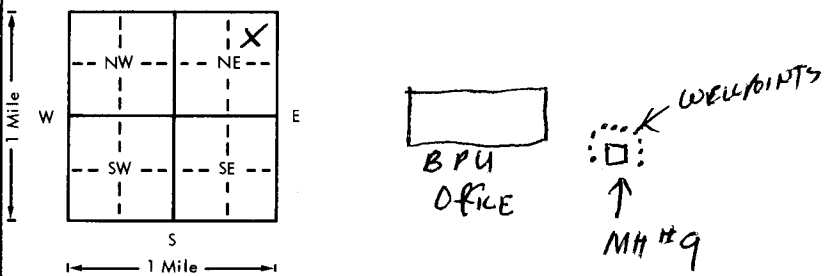


MH #9

USE TYPEWRITER OR BALL POINT PEN-PRESS FIRMLY, PRINT CLEARLY.

MH #9 Install
WATER WELL RECORD
KSA 82a-1201-1215

Kansas Department of Health and Environment-Division of Environment
(Water well Contractors)
Topeka, Kansas 66620

1. Location of well:		County WYANDOTTE	Fraction NE 1/4 NE 1/4 NE 1/4	Section number 23	Township number T 10 S	Range number R 24 E/W
2. Distance and direction from nearest town or city: 3 mi N.W. FROM		3. Owner of well: MORETRENCH AMERICAN		R.R. or street: 5000 KATRINE AVE		
Street address of well location if in city: NEARBY POWER PLANT		City, state, zip code: DOWNERS GROVE IL, 60415				
4. Locate with "X" in section below: N W E S 1 Mile			Sketch map: 		6. Bore hole dia. 12 in. Completion date Well depth 36 ft. 3-29-79	
5. Type and color of material			From	To	7. Cable tool <input type="checkbox"/> Rotary <input type="checkbox"/> Driven <input type="checkbox"/> Dug <input type="checkbox"/> Hollow rod <input checked="" type="checkbox"/> Jetted <input type="checkbox"/> Bored <input type="checkbox"/> Reverse rotary	
					8. Use: <input type="checkbox"/> Domestic <input type="checkbox"/> Public supply <input type="checkbox"/> Industry <input type="checkbox"/> Irrigation <input type="checkbox"/> Air conditioning <input type="checkbox"/> Stock <input type="checkbox"/> Lawn <input type="checkbox"/> Oil field water <input checked="" type="checkbox"/> Other	
Brown Clay			0	20	9. Casing: Material STEEL Height: Above or below Threaded <input checked="" type="checkbox"/> Welded <input type="checkbox"/> Surface 12 in. RMP 14 PVC <input type="checkbox"/> Weight 2.72 lbs./ft. Dia. 1 1/2 in. to 23 ft. depth Wall Thickness: inches or Dia. <input type="checkbox"/> in. to <input type="checkbox"/> ft. depth gage No. 40	
Brown M-to-C Sand			20	26	10. Screen: Manufacturer's name M-T-A Type MESH Dia. 1 1/2 Slot/gauze 3 Length 3 Set between 23 ft. and 26 ft. Set between <input type="checkbox"/> ft. and <input type="checkbox"/> ft. Gravel pack? No Size range of material	
					11. Static water level: 18 ft. below land surface Date 3-29-79 mo./day/yr.	
					12. Pumping level below land surfaces: ____ ft. after ____ hrs. pumping ____ g.p.m. ____ ft. after ____ hrs. pumping ____ g.p.m. Estimated maximum yield ____ g.p.m.	
					13. Water sample submitted: ____ Yes <input checked="" type="checkbox"/> No Date	
					14. Well head completion: No Pitless adapter ____ Inches above grade	
					15. Well grouted? Yes With: ____ Neat cement <input checked="" type="checkbox"/> Bentonite ____ Concrete Depth: From 0 ft. to 12 ft.	
					16. Nearest source of possible contamination: ft. 1000 Direction E Type RIVER Well disinfected upon completion? ____ Yes <input checked="" type="checkbox"/> No	
					17. Pump: Not installed Manufacturer's name DONE Model number ____ HP ____ Volts ____ Length of drop pipe ____ ft. capacity ____ g.p.m. Type: <input type="checkbox"/> Submersible <input type="checkbox"/> Turbine <input type="checkbox"/> Jet <input type="checkbox"/> Reciprocating <input type="checkbox"/> Centrifugal <input type="checkbox"/> Other	
(Use a second sheet if needed)						
18. Elevation: 792		19. Remarks: Jetted 10 well points Around MH #9 MATERIAL UNIFORM FOR EACH WELLPOINT		20. Water well contractor's certification: This well was drilled under my jurisdiction and this report is true to the best of my knowledge and belief. MORETRENCH AMERICAN Business name License No. Address DOWNERS GROVE ILL Signed J. Wagner Date 3-29-79 Authorized representative		

T
R
W
E
S
E
C
10 240 23 NE NE NE

Forward the white, blue and pink copies to the Department of Health and Environment

Form WWC-5