



RECEIVED


JAN 21 2004

BUREAU OF WATER

Wooded Area

Woodson County Lake

Land Clearing

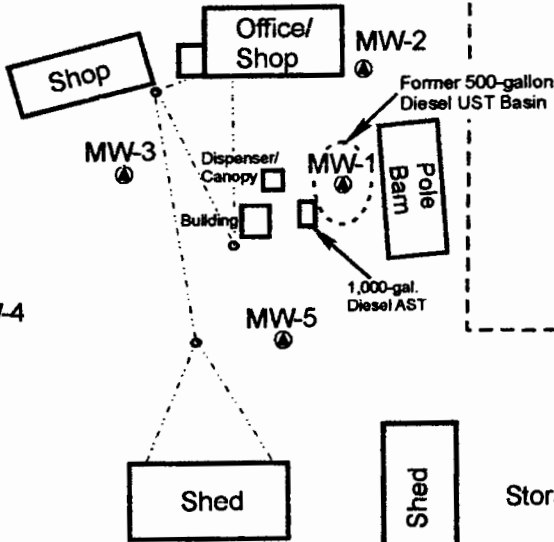

Property Line

Storage Yard

Wooded Area

Road

Wooded Area

Generalized  
Groundwater  
Flow Direction

Wooded Area




**Knightly  
Environmental  
Incorporated**  
Lenexa, Kansas

KEI Job No.: 69-18

Date: 1/19/04

### Notes

- ⊕ Boring Location
- ⊙ Monitoring Well Location
- OHE- Overhead Power (approx. Location)

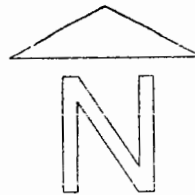

0 ft. 100

Note: Scale Approximate

Figure 1

**Wyandotte County Parks  
Kansas City, Kansas**

## Site Plan