

RECEIVED


JAN 21 2004

BUREAU OF WATER

Wooded Area

Woodson County Lake

Land Clearing

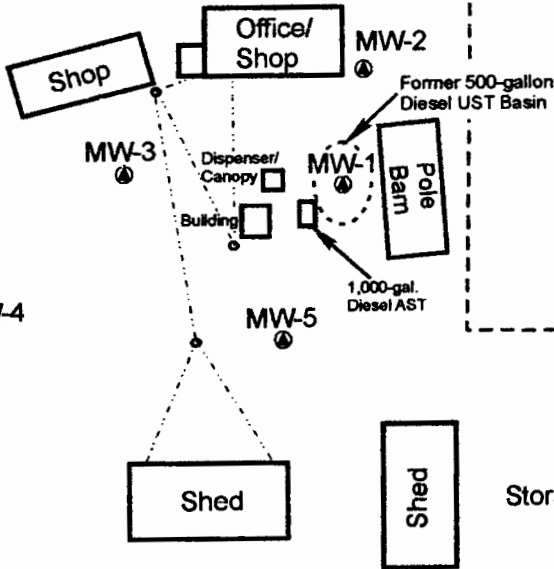

Property Line

Storage Yard

Wooded Area

Road

Wooded Area

Generalized
Groundwater
Flow Direction

Wooded Area




Knightly
Environmental
Incorporated
Lenexa, Kansas

KEI Job No.: 69-18

Date: 1/19/04

Notes

- ⊕ Boring Location
- ⊙ Monitoring Well Location
- OHE- Overhead Power (approx. Location)

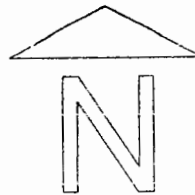

0 ft. 100

Note: Scale Approximate

Figure 1

Wyandotte County Parks
Kansas City, Kansas

Site Plan