



Wyandotte Co

SE SW SE SE 27-10-24E

PROJECT: In and Out Food Mart		PROJECT NUMBER: U4-105-15069		CLIENT: Sam's Investment & Realty LLC		BORING NO.: MW7			
STREET ADDRESS: 5940 Leavenworth Rd. CITY, STATE: Kansas City, KS				DRILLING CONTRACTOR: Razek		DRILL RIG TYPE: DPT/HSA			
GEOLOGIST: Ryan Weiser		DATE	STARTED: 12/17/18		BORING DIAMETER: 2.25/8.25		TOP OF CASING ELEVATION:		
DRILL CREW: Greg Goode, Tony Poulter			COMPLETED: 12/17/18		TOTAL DEPTH: 25'		GROUNDWATER DEPTH:		
				PAD ELEVATION:		SWL ELEVATION:			
DEPTH (ft)	<u>Soil Group Name:</u> modifier, color, moisture, density/consistency, grain size, other descriptors						PID (ppm)	LAB SAMPLES	BORING COMPLETION
	<u>Rock Description:</u> modifier, color, hardness/degree of concentration, bedding and joint characteristics, solutions, void conditions.								
10	Topsoil. Brown/Black. Silty-Sandy Clay loam; moist, no odor.						0		
	CLAY. Brown, Clayey, plastic, moist, no odor.						0		
							NR		
							0		
	Clay. Brown-Orange, plastic; moist; Silty-Slightly Sandy; no odor, black nodules.						0		
							0		
	CLAY. Brown, Clayey, plastic, moist, no odor.						0		
							0		
	Clay. Grey-Tan; Silty; no odor, moist increasing from 19-20, very plastic; white chert nodules/chips; black organics.						0		
							0		
BEDROCK REFUSAL									
30	Soil samples collected continuously with dual tube sampler.								
ABBREVIATIONS: UNK - Unknown Total Depth = 25' HSA - Hollow-stem auger Casing Diameter=2" DPT - Direct-push technology NR - No Recovery PID - Photionization detector									

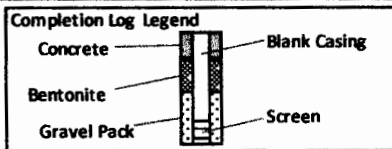

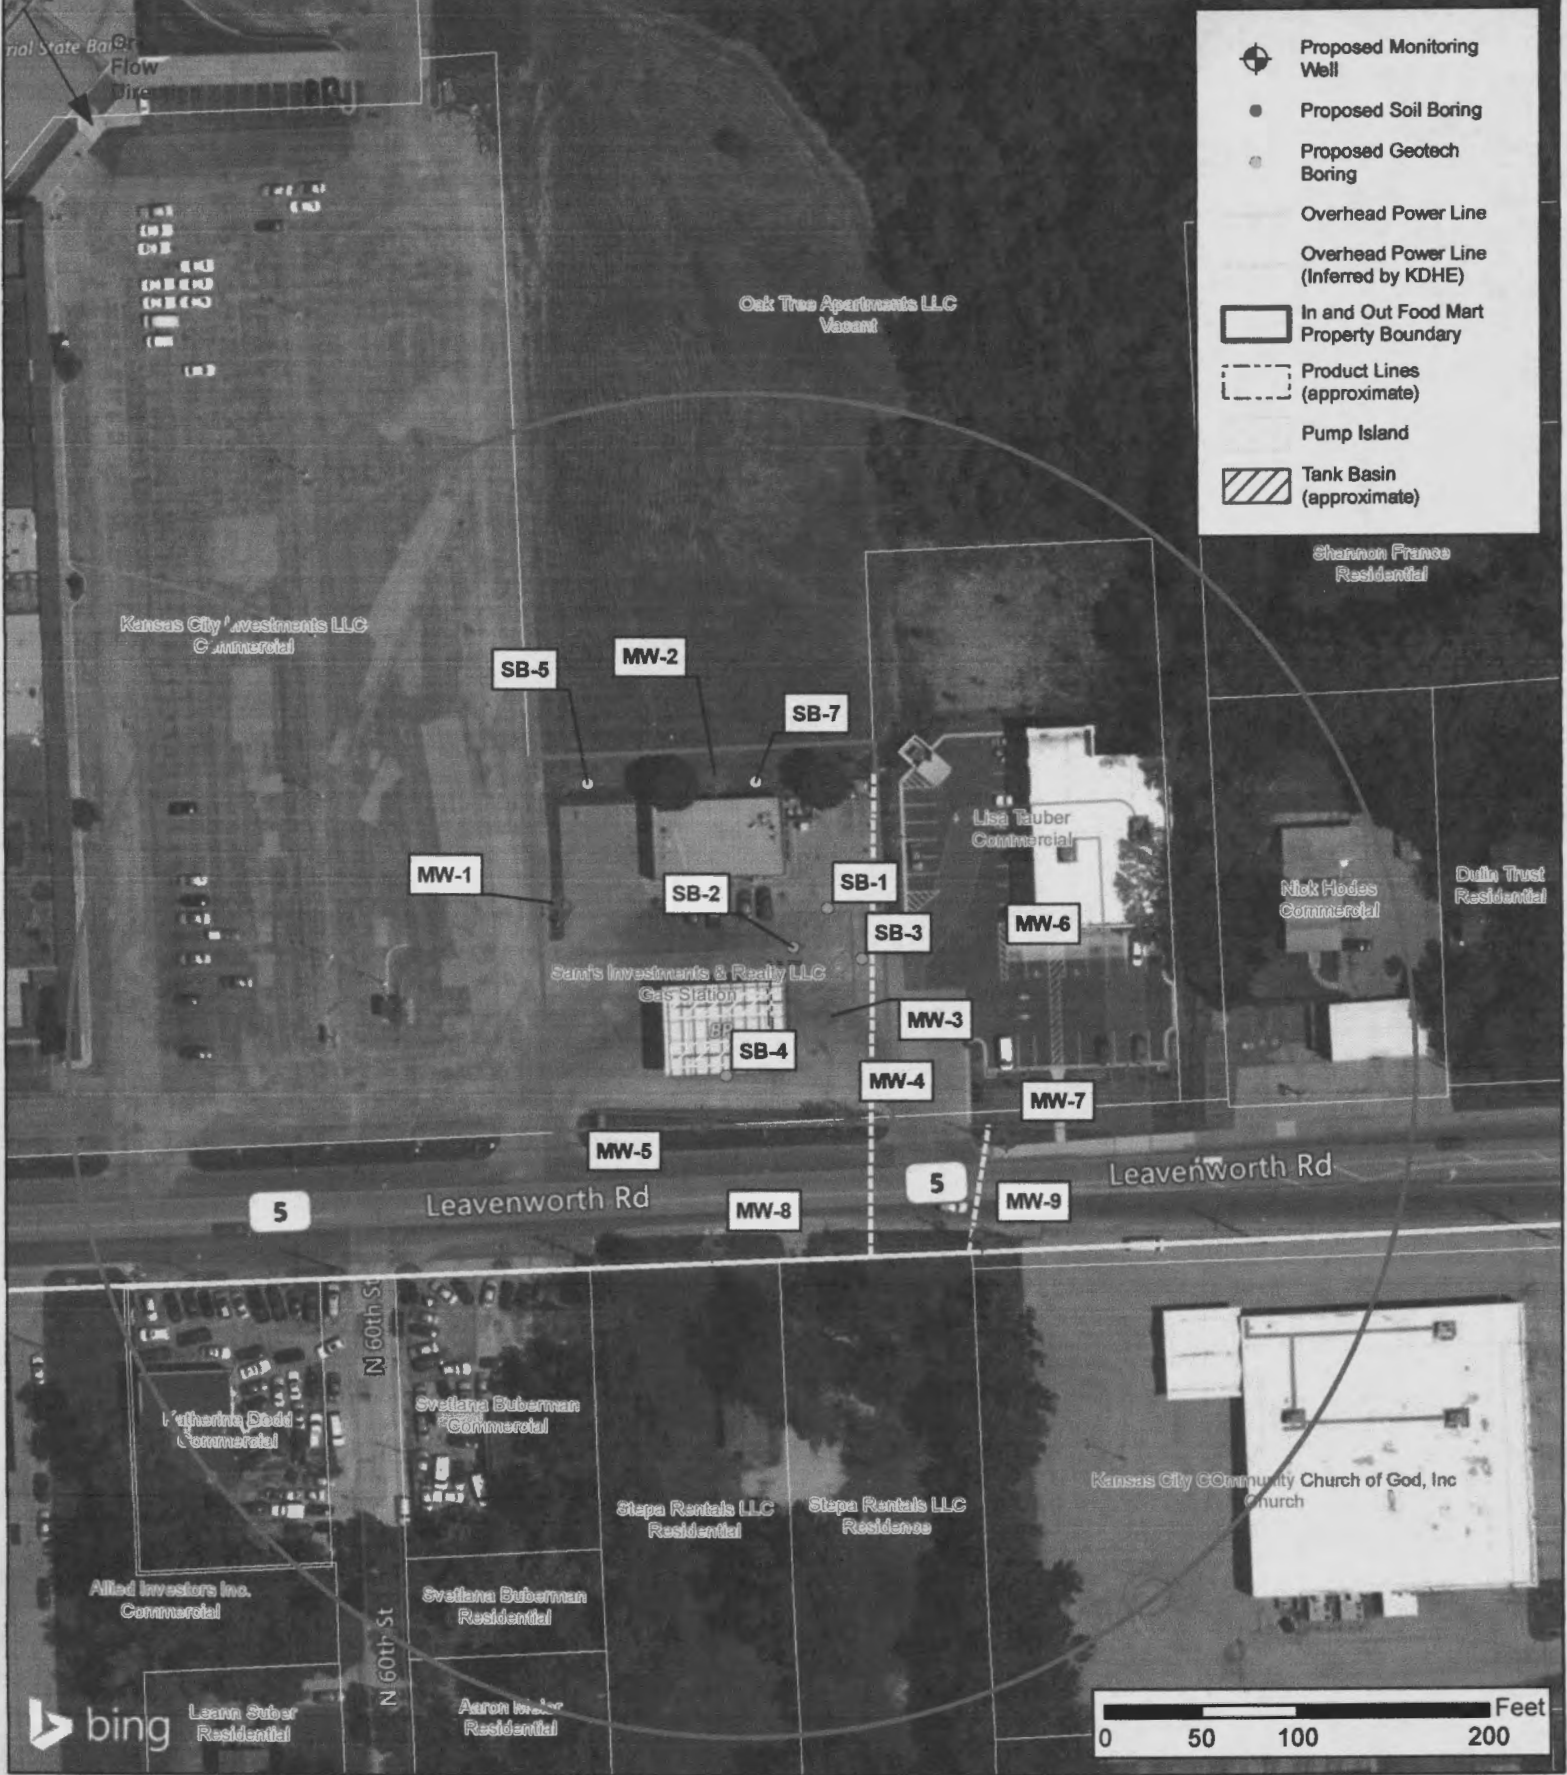

DESIGNED BY:	CC
DRAWN BY:	CC
CHECKED BY:	RW
APPROVED BY:	CC
DATE:	SEPTEMBER 2018



**Detailed Site Map (350-ft)
In and Out Food Mart**

ppB EnviroSolutions
professional | practical | below-ground

U4-105-15069
5940 Leavenworth Road
Kansas City, KS

**FIGURE
3**

LSA Work Plan