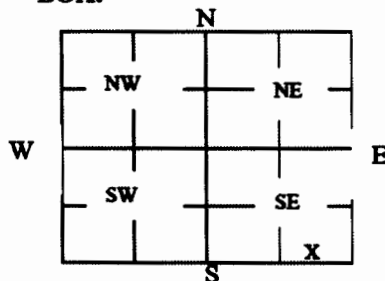


## WATER WELL PLUGGING RECORD Form WWC-5P

KSA 82a-1212 ID NO.

MW-5

<b>1 LOCATION OF WATER WELL:</b> County: <b>Wyandotte</b> Street/Rural Address of Well Location; if unknown, distance & direction from nearest town or intersection: If at owner's address, check here <input type="checkbox"/> <b>In and Out Food Mart</b> <b>5940 Leavenworth Rd</b> <b>Kansas City, Kansas 66106</b> <b>KDHE Project Code: U4-105-15069</b>	Fraction <b>SE ¼ SW ¼ SE ¼ SE ¼</b>	Section Number <b>27</b>	Township Number <b>T 10 S</b>	Range Number <b>24</b> <input checked="" type="checkbox"/> E <input type="checkbox"/> W
Global Positioning Systems (GPS) information: Latitude: <b>39.14323</b> (in decimal degrees) Longitude: <b>-94.71731</b> (in decimal degrees) Elevation: <b>953.54</b> Horizontal Datum: <input checked="" type="checkbox"/> WGS84, <input type="checkbox"/> NAD83, <input type="checkbox"/> NAD27 Collection Method:		<input type="checkbox"/> GPS unit (Make/Model: _____) <input type="checkbox"/> Digital Map/Photo, <input type="checkbox"/> Topographic Map, <input checked="" type="checkbox"/> Land Survey Est. Accuracy: <input checked="" type="checkbox"/> < 3 m, <input type="checkbox"/> 3-5 m, <input type="checkbox"/> 5-15 m, <input type="checkbox"/> > 15 m		
<b>2 WATER WELL OWNER:</b> Sam's Investments and Realty, LLC RR#, St. Address, Box #: 10718 W. 162nd St. City, State ZIP Code: Overland Park, KS 66062				

**3 MARK WELL'S LOCATION WITH AN "X" IN SECTION BOX:****4 DEPTH OF WELL 30.80 ft.**WELL'S STATIC WATER LEVEL **19.70** ft

WELL WAS USED AS:

☐ Domestic  
☐ Irrigation  
☐ Feedlot  
☐ Industrial

☐ Public Water Supply  
☐ Oil Field Water Supply  
☐ Domestic (Lawn & Garden)  
☐ Air Conditioning

☐ Dewatering  
☒ Monitoring  
☐ Injection Well  
☐ Other \_\_\_\_\_
Was a chemical/bacteriological sample submitted to Department? Yes ☐ No ☒**5 TYPE OF BLANK CASING USED:**
☐ Steel  
☒ PVC

☐ RMP (SR)  
☐ ABS

☐ Wrought  
☐ Asbestos-Cement

☐ Fiberglass  
☐ Concrete Tile
☐ Other (Specify below) \_\_\_\_\_Blank casing diameter **2** in. Was casing pulled? Yes ☒ No ☐ If yes, how much **3** ftCasing height above or below land surface **0** in.**6 GROUT PLUG MATERIAL:**☐ Neat cement☐ Cement grout☒ Bentonite☐ Other \_\_\_\_\_Grout Plug Intervals: From **30.80** ft. to **3** ft., From \_\_\_\_\_ ft. to \_\_\_\_\_ ft., From \_\_\_\_\_ ft. to \_\_\_\_\_ ft.

What is the nearest source of possible contamination:

☐ Septic tank  
☐ Sewer lines  
☐ Watertight sewer lines  
☐ Lateral lines  
☐ Cess pool

☐ Seepage pit  
☐ Pit privy  
☐ Sewage lagoon  
☐ Feedyard  
☐ Livestock pens

☒ Fuel storage  
☐ Fertilizer storage  
☐ Insecticide storage  
☐ Abandoned water well  
☐ Oil well/Gas well
☐ Other (specify below) \_\_\_\_\_

Direction from well? \_\_\_\_\_

How many feet? \_\_\_\_\_

FROM	TO	PLUGGING MATERIALS	FROM	TO	PLUGGING MATERIALS
30.80	3	Bentonite Chips			
3	0.5	Clean compacted silt/clay			
0.5	0	Soil			

**7 CONTRACTOR'S OR LANDOWNER'S CERTIFICATION:** This water well was plugged under my jurisdiction and was completed on (mo/day/year) **12/9/2020** and this record is true to the best of my knowledge and belief. Kansas Water Well Contractor's License No. **pg #762**. This Water Well Record was completed on (mo/day/year) **12/5/2021** under the business name of **ppB enviro-solutions** by (signature) \_\_\_\_\_

Send one white copy to Kansas Department of Health & Environment, Geology Section, 1000 SW Jackson Street, Ste. 420, Topeka, KS 66612-1367. Send one copy to WATER WELL OWNER and retain one for your records.

Visit us at <http://www.kdheks.gov/waterwell/index.html> Telephone 785-296-5524.

KSA82a-1212

Revised 1/20/2015