USE TYPEWRITER OR BALL POINT PEN-PRESS FIRMLY, PRINT CLEARLY.

WATER WELL RECORD
KSA 82a-1201-1215

Kansas Department of Health and Environment-Division of Environment
(Water well Contractors)
Topeka, Kansas 66620

1. Location of well:	County	Fraction	Section number	Township number	Range number
	Wyandotte	SW 1/4 SE 1/4 NE 1/4	13	T 10-S S	R 24 E/W

2. Distance and direction from nearest town or city: West - 5mi ±

Street address of well location if in city:

3. Owner of well: Shawnee Const. Co.
R.R. or street: 6319 Kansas Avenue
City, state, zip code: Kansas City, KS 66111

4. Locate with "X" in section below:

Sketch map: 1

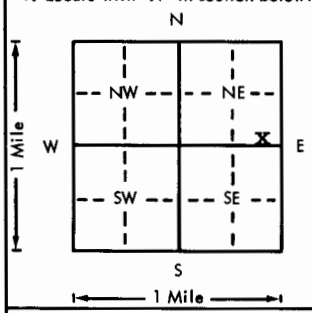

6. Bore hole dia. 30 in. Completion date 5-16-77
Well depth 100 ft.

7. __ Cable tool __ Rotary __ Driven __ Dug
__ Hollow rod __ Jetted __ Bored X Reverse rotary

8. Use: __ Domestic __ Public supply __ Industry
__ Irrigation __ Air conditioning __ Stock
__ Lawn __ Oil field water X Other

9. Casing: Material Steel Height: Above or below
Threaded ___ Welded X Surface 2' above in.
RMP ___ PVC ___ Weight 33 lbs./ft.
Dia. 16 in. to 70 ft. depth Wall Thickness: inches or
Dia. ___ in. to ___ ft. depth gage No. 1/4"

5. Type and color of material	From	To
Clay	0	10
Brown Med. Fine Sand	10	50
Medium coarse sand with gravel layers	50	100

(Use a second sheet if needed)

10. Screen: Manufacturer's name Doerr
Type Punched Dia. 16"
Slot/gauze 1/16" Length 30
Set between 70 ft. and 100 ft.
___ ft. and ___ ft.
Gravel pack? X Size range of material 1/4"

11. Static water level: mo./day/yr.
16 ft. below land surface Date 5-16-77

12. Pumping level below land surfaces:
50 ft. after 10 hrs. pumping 1500 g.p.m.
___ ft. after ___ hrs. pumping ___ g.p.m.
Estimated maximum yield 1500 g.p.m.

13. Water sample submitted: mo./day/yr.
__ Yes X No Date ___

14. Well head completion: Temp. Dis. Head
__ Pitless adapter ___ Inches above grade

15. Well grouted? No
With: __ Neat cement __ Bentonite __ Concrete
Depth: From ___ ft. to ___ ft.

16. Nearest source of possible contamination:
ft. ___ Direction ___ Type ___
Well disinfected upon completion? ___ Yes X No

17. Pump: __ Not installed
Manufacturer's name Aurora
Model number ___ HP 60 Volts ___
Length of drop pipe 60 ft. capacity 7000 g.p.m.
Type:
__ Submersible X Turbine
__ Jet __ Reciprocating
__ Centrifugal __ Other

18. Elevation: 743
Topography:
__ Hill
__ Slope
__ Upland
X Valley

19. Remarks:

20. Water well contractor's certification:
This well was drilled under my jurisdiction and this report is true to the best of my knowledge and belief.
Business name Southern Wellpoint Co., Inc. License No. #235
Address 2935 N. Toledo, Tulsa, OK
Signed A. W. Macomber Date 7-1-77
Authorized representative
A. W. Macomber, President

Forward the white, blue and pink copies to the Department of Health and Environment

Form WWC-5

T 10 R 24 E/W Sec 13 SW SE NE 1/4 1/4 1/4

M1-1023