24 MH #16

USE TYPEWRITER OR BALL POINT PEN-PRESS FIRMLY, PRINT CLEARLY.

where worked ?

not in CF

MH #16 Remove

WATER WELL RECORD
KSA 82a-1201-1215

Kansas Department of Health and Environment-Division of Environment
(Water well Contractors)
Topeka, Kansas 66620

1. Location of well:	County	Fraction	Section number	Township number	Range number
	Wyandotte	S.E. 1/4 S.W. 1/4 S.W. 1/4	13	T 10 S	R 24 (E) W

2. Distance and direction from nearest town or city: 3 mi. N.W. of Kansas City Ks
Street address of well location if in city: Nearman Power Plant

3. Owner of well: Morgerech - American
R.R. or street: 5200 Katrine Ave
City, state, zip code: Downers Grove, Ill 60515

4. Locate with "X" in section below:

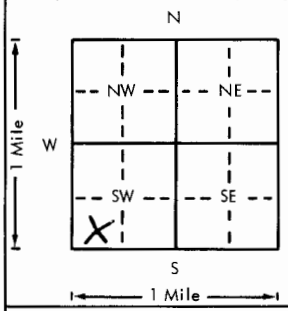

Sketch map:

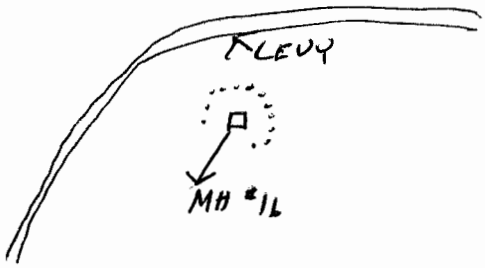

6. Bore hole dia. 12 in. Completion date 5-10-79
Well depth 26 ft.

7. __ Cable tool __ Rotary __ Driven __ Dug
__ Hollow rod X Jetted __ Bored __ Reverse rotary

8. Use: __ Domestic __ Public supply __ Industry
__ Irrigation __ Air conditioning __ Stock
__ Lawn __ Oil field water X Other

9. Casing: Material Steel Height: Above or below
Threaded X Welded ___ Surface 12 in.
RMP ___ PVC ___ Weight 2.21 lbs./ft.
Dia. 1½ in. to 23 ft. depth Wall Thickness: inches or
Dia. ___ in. to ___ ft. depth gage No. 40

10. Screen: Manufacturer's name M-T-A
Type Mesh Dia. 1½
Slot/gauze ___ Length 3
Set between 23 ft. and 26 ft.
___ ft. and ___ ft.
Gravel pack? ___ Size range of material ___

11. Static water level: 12 ft. below land surface Date 5-10-79 (mo./day/yr.)

12. Pumping level below land surfaces:
___ ft. after ___ hrs. pumping ___ g.p.m.
___ ft. after ___ hrs. pumping ___ g.p.m.
Estimated maximum yield ___ g.p.m.

13. Water sample submitted: mo./day/yr.
__ Yes X No Date ___

14. Well head completion:
No Pitless adapter ___ Inches above grade

15. Well grouted? Yes
With: ___ Neat cement X Bentonite ___ Concrete
Depth: From 0 ft. to 12 ft.

16. Nearest source of possible contamination:
ft. 1000 Direction N Type River
Well disinfected upon completion? ___ Yes X No

17. Pump: Not installed
Manufacturer's name None
Model number ___ HP ___ Volts ___
Length of drop pipe ___ ft. capacity ___ g.p.m.
Type:
__ Submersible __ Turbine
__ Jet __ Reciprocating
__ Centrifugal __ Other

5. Type and color of material

	From	To
Pull + Grout 12		
Wellpoint Holes - Grouting Holes		
From EL 740' to 752' - Ground		
EL is 752'		

(Use a second sheet if needed)

18. Elevation: 750
Topography:
__ Hill
__ Slope
__ Upland
X Valley

19. Remarks: Pull + Grout 12 wellpoints Around MH #16 - Use Bentonite For Grout - Grout -12' - 0'

20. Water well contractor's certification:
This well was drilled under my jurisdiction and this report is true to the best of my knowledge and belief.
Business name M-T-A License No. ___
Address 5200 Katrine, Downers Grove, Ill
Signed J Wagner Date 5-10-79
Authorized representative

T 10 R 24 (E) W Sec 13 1/4 SE 1/4 SW 1/4 SW 1/4

Forward the white, blue and pink copies to the Department of Health and Environment

Form WWC-5

BR in this area any 100 - 130 feet below surface
∴ BR = 620 - 650 D = 730

MI-1023