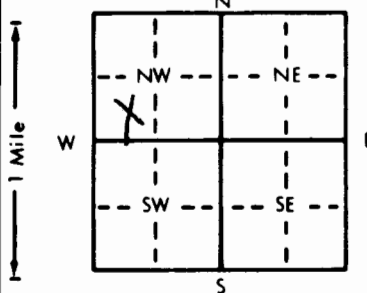


1 LOCATION OF WATER WELL: Fraction N = 373,866 E = 2,297,988 Section Number 13 Township Number T 10 S Range Number R 24 EW
 County: Wyandotte SA 1/4 SW 1/4 SE 1/4

Distance and direction from nearest town or city street address of well if located within city?
 North of Nearman Creek Generating Station Along Southern Bank of Missouri River

2 WATER WELL OWNER: Board of Public Utilities
 RR#, St. Address, Box #: 1211 N. 8th Street Board of Agriculture, Division of Water Resources
 City, State, ZIP Code: Kansas City, KS 66101 Application Number:

3 LOCATE WELL'S LOCATION WITH AN "X" IN SECTION BOX:

 4 DEPTH OF COMPLETED WELL: 122 ft. ELEVATION: 750.69' NSL (PVC)
 Depth(s) Groundwater Encountered: 1. ft. 2. ft. 3. ft.
 WELL'S STATIC WATER LEVEL: 7.39' (NSL) ft. below land surface measured on mo/day/yr 9/28/93
 Pump test data: Well water was . ft. after . hours pumping . gpm
 Est. Yield . gpm: Well water was . ft. after . hours pumping . gpm
 Bore Hole Diameter: 6 in. to 122 ft., and . in. to . ft.
 WELL WATER TO BE USED AS:
 5 Public water supply 8 Air conditioning 11 Injection well
 1 Domestic 3 Feedlot 6 Oil field water supply 9 Dewatering 12 Other (Specify below)
 2 Irrigation 4 Industrial 7 Lawn and garden only 10 Monitoring well
 Was a chemical/bacteriological sample submitted to Department? Yes (No); If yes, mo/day/yr sample was submitted
 Water Well Disinfected? Yes No

5 TYPE OF BLANK CASING USED:
 1 Steel 3 RMP (SR) 5 Wrought iron 8 Concrete tile CASING JOINTS: Glued . Clamped .
 2 PVC 4 ABS 6 Asbestos-Cement 9 Other (specify below) Welded .
 7 Fiberglass Threaded.
 Blank casing diameter: 2 in. to 122 ft., Dia . in. to . ft., Dia . in. to . ft.
 Casing height above land surface . in., weight . lbs./ft. Wall thickness or gauge No. .
 TYPE OF SCREEN OR PERFORATION MATERIAL:
 1 Steel 3 Stainless steel 5 Fiberglass 8 RMP (SR) 10 Asbestos-cement
 2 Brass 4 Galvanized steel 6 Concrete tile 9 ABS 11 Other (specify) .
 12 None used (open hole)
 SCREEN OR PERFORATION OPENINGS ARE:
 1 Continuous slot 3 Mill slot 5 Gauzed wrapped 8 Saw cut 11 None (open hole)
 2 Louvered shutter 4 Key punched 6 Wire wrapped 9 Drilled holes
 7 Torch cut 10 Other (specify) .
 SCREEN-PERFORATED INTERVALS: From . 122 ft. to . 122 ft., From . ft. to . ft.
 From . ft. to . ft., From . ft. to . ft.
 GRAVEL PACK INTERVALS: From . ft. to . ft., From . ft. to . ft.
 From . ft. to . ft., From . ft. to . ft.

6 GROUT MATERIAL: 1 Neat cement 2 Cement grout 3 Bentonite 4 Other .
 Grout intervals: From . 9 ft. to 0 (Grade) ft., From . ft. to . ft., From . ft. to . ft.
 What is the nearest source of possible contamination:
 1 Septic tank 4 Lateral lines 7 Pit privy 10 Livestock pens 14 Abandoned water well
 2 Sewer lines 5 Cess pool 8 Sewage lagoon 11 Fuel storage 15 Oil well/Gas well
 3 Watertight sewer lines 6 Seepage pit 9 Feedyard 12 Fertilizer storage 16 Other (specify below)
 13 Insecticide storage .
 Direction from well? How many feet?

FROM	TO	LITHOLOGIC LOG	FROM	TO	PLUGGING INTERVALS
0	20'	Gray Silty Clay			
20	55'	Fine-Med Sand; Gray Clay			
55'	56'	Clay			
56'	63'	Fine-Coarse Sand w/ lignite and Clay Balls			
63	77'	Fine-Coarse Sand w/ heavy silt; organics			
77'	80'	Fine-Coarse Sand w/ Scatt. Gravel			
80'	122'	Coarse Sand - Fine Gravel w/ Med. lg. Gravel; Scatt. Cobbles			
		P-2			

7 CONTRACTOR'S OR LANDOWNER'S CERTIFICATION: This water well was 1 constructed (2) reconstructed, or (3) plugged under my jurisdiction and was completed on (mo/day/year) 9/3/93 and this record is true to the best of my knowledge and belief. Kansas Water Well Contractor's License No. . This Water Well Record was completed on (mo/day/yr) 10/19/93 under the business name of Ranney Div., Hydro Group, Inc. by (signature) Gregory B. Stone, geologist

OFFICE USE ONLY
T
R
EW
SEC.